


KANSAS Rice

Section 3 Township 21 Range 6W

Well No. 6 Rainey

Company H. C. Bennett et al

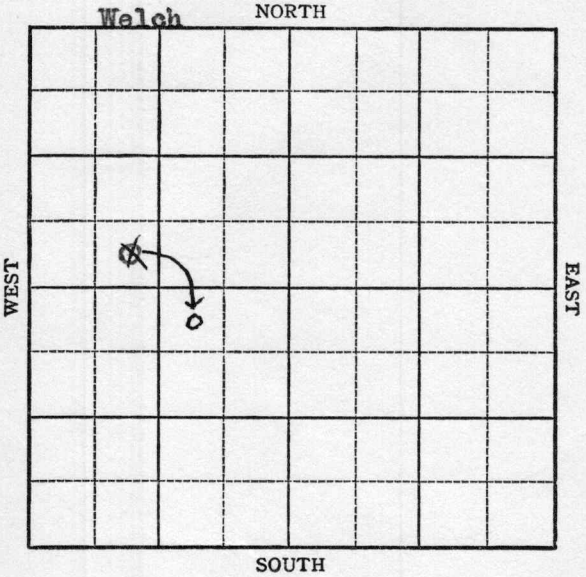

3

KANSAS

Rice
21

6W

Sec. _____ Twp. _____ R. _____

Well No. #6 Rainey Farm _____

H.C. Bennett etal. Company _____

Welch

330 Ft. from N. Line

330

_____ Ft. from S. Line


990 Ft. from E. Line

990

_____ Ft. from W. Line

~~SE SW NW~~

NW NE SW.

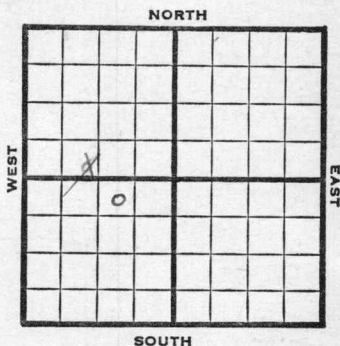

1947

Elev. 1586 REPORT

9/10

RUR

9/17

10" @ 160'
Drlg. 2000'

9/24

Drlg. 3050'

10/1

Mississippi 3402'
TD 3404'
7" @ 8402'
RUST

10/8

"

10/15

Miss 3402
7" @ 3402
Pump 50 Pot,
TD 3419
Gravity 36

COMPLETED

Map No. _____ Sec. 3 Twp. 21 R. 6W

Well No. 6 Rainey

H. C. Bennett et al. Company

FIRST REPORT Contractor

SE SW NW


SECTION PLAT

_____ Ft. from N. Line

330 Ft. from S. Line

_____ Ft. from E. Line

990 Ft. from W. Line

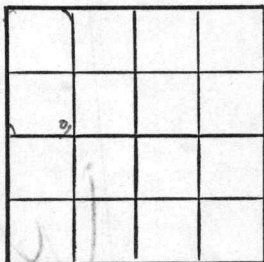

Rice County

Location _____

Rig up _____

Drilling and Remarks:

R U R

RECORD

Cased _____ in., _____ ft.

Sand _____

Gas _____

Oil _____

Total Depth _____

PRODUCTION

1st 24 hrs. Nat. _____

1st 24 hrs. after shot _____

Gas _____ Cu. Ft.

Dry Hole _____

Abandoned _____

Date

SEP 10 1947

19

S. J. LEWIS

Scout

Map No. 48 Sec. 3 Twp. 21 R. 6W

Well No. 6 Rainey

H. C. Bennett et al. Company

CORRECTION

Contractor

NW NE SW

SECTION PLAT

330 Ft. from N. Line

_____ Ft. from S. Line

990 Ft. from E. Line

_____ Ft. from W. Line

	o		

Rice County

Location _____

Rig up _____

Drilling and Remarks:

Reported

SE SW NW

RECORD

Cased _____ in., _____ ft.

Sand _____

Gas _____

Oil _____

Total Depth _____

PRODUCTION

1st 24 hrs. Nat. _____

1st 24 hrs. after shot _____

Gas _____ Cu. Ft.

Dry Hole _____

Abandoned _____

Date

SEP 17 1947 19

S. J. LEWIS

Scout

Map No. 48 Sec. 3 Twp. 21 R. 6W

Well No. 6 Rainey

H. C. Bennett et al. Company

COMPLETE

Contractor

NW NE SW

E. 1/4
SECTION PLAT

	0		

330 Ft. from N. Line

 Ft. from S. Line

990 Ft. from E. Line

 Ft. from W. Line

Rice County

Location

Rig up

Drilling and Remarks:

Miss 8402.

7' @ 8402.

Pump 50 PD

36 1/2

RECORD

Cased in., ft.

Sand

Gas

Oil

Total Depth 8419

PRODUCTION

1st 24 hrs. Nat.

1st 24 hrs. after shot

Gas Cu. Ft.

Dry Hole

Abandoned

Date

OCT 15 1947 19

S. J. LEWIS

Scout