


Section 6 Township 21 Range 6W

Well No. #1 Willhaus

Company B & R Drlg.

Wildcat

NORTH

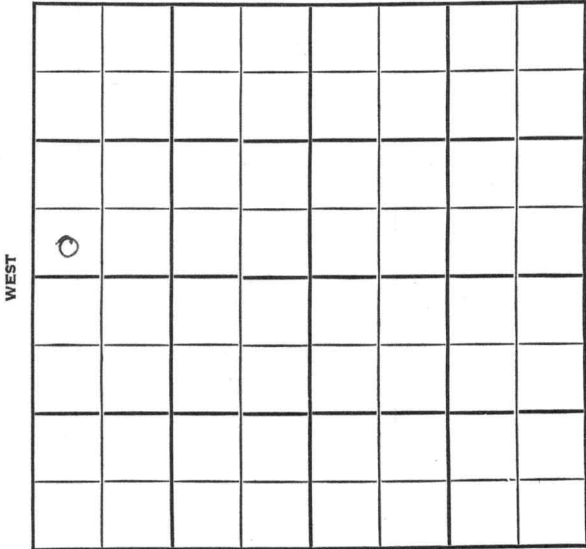

SOUTH

Sec. 6 Twp. 21 R. 6W Rice

Well No. #1 Willhaus Farm
B & R Drlg. Company

Wildcat


 Ft. from N. Line

330' Ft. from S. Line

 Ft. from E. Line

330' Ft. from W. Line

SW NW

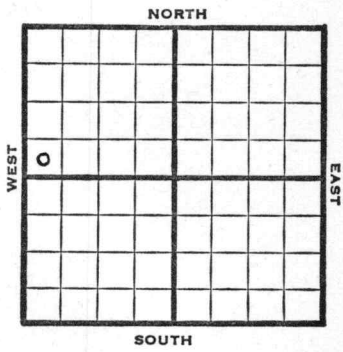

1948 Elev. 1687' REPORT

2/11 RUR
2/18 8" @ 150'
Drlg 2010'
2/25 Conglomerate 3457-62' TD
5" @ 3457'
RUST
3/3 "
3/10 Miss. 3531'
TD 3540'
ABANDONED

Map No. _____ Sec. 6 Twp. 21 R. 6W

Well No. 1 Willhaus

B & R Drlg. Company

FIRST REPORT Contractor

SW NW

SECTION PLAT

_____ Ft. from N. Line

330 Ft. from S. Line

_____ Ft. from E. Line

330 Ft. from W. Line

Rice County

Location _____

Rig up _____

Drilling and Remarks:

R U R

RECORD

Cased _____ in., _____ ft.

Sand _____

Gas _____

Oil _____

Total Depth _____

PRODUCTION

1st 24 hrs. Nat. _____

1st 24 hrs. after shot _____

Gas _____ Cu. Ft.

Dry Hole _____

Abandoned _____

Date

FEB 1 1 1948 19

S. J. LEWIS Scout

Map No. 48 Sec. 6 Twp. 21 R. 6W

Well No. 1 Willhaus

B & R Drlg.

Company

ABANDONED

Contractor

SW NW

B. 11/687
SECTION PLAT

<u>6</u>			

 Ft. from N. Line

330 Ft. from S. Line

 Ft. from E. Line

330 Ft. from W. Line

Rice County

Location

Rig up

Drilling and Remarks:

Miss 353!

RECORD

Cased in., ft.

Sand

Gas

Oil

Total Depth 335-40

PRODUCTION

1st 24 hrs. Nat.

1st 24 hrs. after shot

Gas Cu. Ft.

Dry Hole

Abandoned

Date

MAR 10 1948 19

S. J. LEWIS Scout