


Rice

KANSAS

SECTION 7 TOWNSHIP 21 RANGE 6W

WELL NO. #2 Dresbach

COMPANY F.G. Holl & Tom Allan

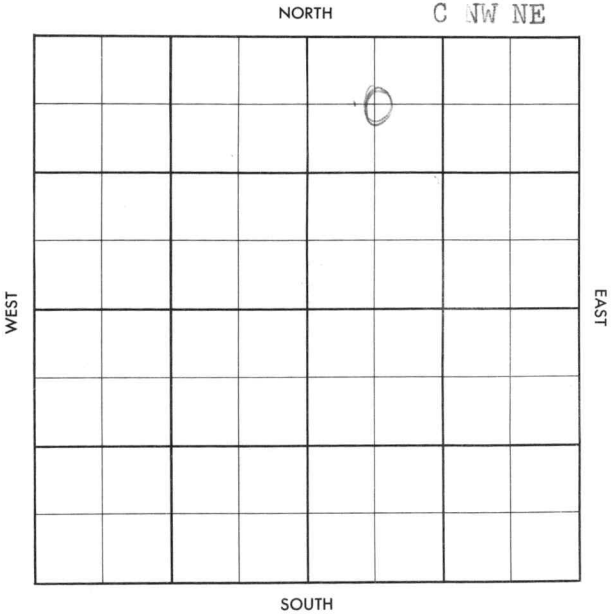

County Rice Elev. 1694
 Sec. 7 Twp. 21 Rge. 6W
 Company F. G. Holl & Tom Allan
 Farm Name Dresbach No. 2

TOPS	DEPTH	LOG	DATUM
Anh.			
Tr.			
H.			
Tr.			
Dg.			
BL.			
L.			
K.C.			
B.K.C.			
Ce.			
C.	3497		
M.	3507		
M.			
K.			
Mz.			
Mq.			
V.			
S.			
S.			
A.			
R.			
Pe.			
G.			
T.D.	3513		

Loc. in Sec. C NW NE


Geol. _____

Contr. _____

Allan

Pool

Wherry

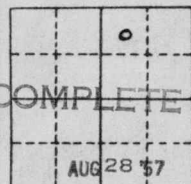

Date Comm. 7-22-57

8" @ 226/150 WOC JUL 31 '57 ϕ 3215

AUG 8 '57 5 1/2 3508/75 DD 3516 1/2

\$ 160ph no/w Δ \$ 12

Goph. no/w FRAC \$ 22

Bo + $\odot$ Ld in blue AUG 14 '57 POP

P 2 1/2 Boph + 9 BWph AUG 21 '57

Pmp 13 Bo PD + lots wtr AUG 28 '57 P. 20

Bo PD + 29 % wtr.

County Rice Elev. _____
 Sec. 7 Twp. 21 Rge. 6W
 Company F. G. Holl & Tom Allan
 Farm Name Dresbach No. 2

TOPS	DEPTH	LOG	DATUM	Loc. in Sec.
Anh.				C NW NE
Tp.				
H.				
Tr.				
Dg.				
Bl.				
L.				Geol.
K.C.				Contr
B.K.C.				Allan
Ce.				Pool
C.				Wherry
M.				
M.				
K.				
Mz.				
Me.				
V.				
S.				
S.				
A				
R.				
Pt.				
G.				
T.D.				

FIRST REPORT

JUL 24 1957

Date Comm. 7-22-57
8" @ 226/150 WOC

12