

Form 51—5M—7-40—Palace

Section 7 Township 21 Range 6-W

Well No. 1 Dresback

Company W. L. Hartman

NORTH Semi-Wildcat



Sec. 7 Twp. 21 R. 6-WWell No. #1 Dresback FarmW. L. Hartman Company

(Semi-Wildcat)

 Ft. from N. Line660 Ft. from S. Line330 Ft. from E. Line Ft. from W. Line

Elev. 1692

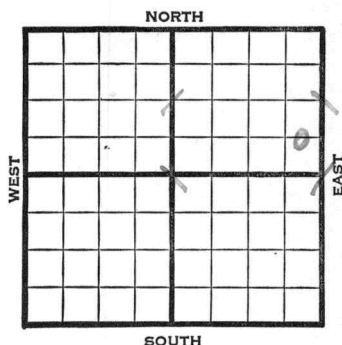

1941

REPORT

1/8

8" - 141' Anhy. 545'

Ft. Riley 1290'

Drlg. 2200'

1/16

Topeka 2450' Lans. 2963'

Drlg. 3430'

1/23

Cong. 3510' Miss. 3517'

5" - 3518' T.D. 3526'

Shot 5 qts. 3521-25' C. O.

1/30

36 shots 3510-17½' P.B. 3520'

Swab 1 bbl. per hour, S.W. 8
hours.

2/6

Inc. water 3556-61' T.D. P.B.

2/13

P.B. to 3537'

2/20

" "

OVER

1941
2/26

Miss. 3517'

5" - 3518'

T.D. 3561'

Pump 18 oil & 28 water in 24
hours.

ABANDONED

Map No. 48 Sec. 7 Twp. 21 R. 6WWell No. 1 DresbackW. L. Hartman

Company


Contractor

FIRST REPORT

C E L S E N E

 Ft. from N. Line660 Ft. from S. Line330 Ft. from E. Line Ft. from W. Line

SECTION PLAT

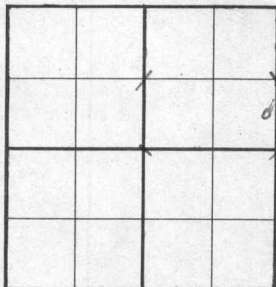

SEMI-WILDCAT

Location Rig up

Drilling and Remarks:

8" - 141'Anhy. 545Ft. Riley 1290Drlg. 2200

RECORD

Cased in., ft.Sand Gas Oil Total Depth

PRODUCTION

1st 24 hrs. Nat. 1st 24 hrs. after shot Gas Cu. Ft.Dry Hole Abandoned

Date

JAN 8 194119S. J. LEWIS Scout

KANSAS

Map No. 48 Sec. 7 Twp. 21 R. 6WWell No. 1 Dresback

W. L. Hartman

Company

Contractor

ABANDONED

C E L S E N E

Ft. from N. Line

660 Ft. from S. Line330 Ft. from E. Line

Ft. from W. Line

SEMI-WILDCAT

SECTION PLAT

			o

Location _____

Rig up _____

Drilling and Remarks:

*Miss 3512**5" @ 3515**Pump. 18 Dil 28 Water**in 24 hrs.*

RECORD

Cased _____ in., _____ ft.

Sand _____

Gas _____

Oil _____

Total Depth 3561

PRODUCTION

1st 24 hrs. Nat. _____

1st 24 hrs. after shot _____

Gas _____ Cu. Ft.

Dry Hole _____

Abandoned _____

Date

FEB 26 1941

19

S. J. LEWIS

Scout