

KANSAS

Rice

Section 7 Township 21 Range 6W

Well No. 1 Dresback

Company Holl & Branine

Wherry Pool

NORTH

WEST

EAST

							0

SOUTH

KANSAS

Rice
21

6W

Sec. 7 Twp. _____ R. _____

Well No. #1 Dresback Farm _____

Holl & Branine Company

Wherry Pool


330' Ft. from N. Line

_____ Ft. from S. Line

330' Ft. from E. Line

_____ Ft. from W. Line

NE/C

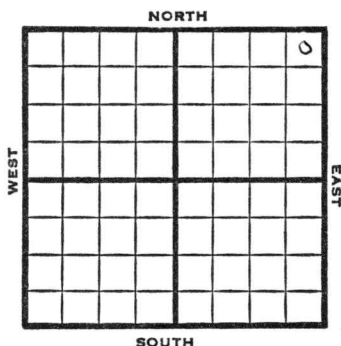

1948

Eli 1707'

R E P O R T

11/10 Location
11/16 "
11/23 8" @ 178'
Drlg 200'
11/30 Drlg 3148'
12/6 Conglomerate 3506'
5" @ 3507
TD
12/15 TD 3551'
Cong 3506'
5" @ 3507'
Miss 3543'
Pump 35 Oil Pot
39° Gr.
Camp

COMPLETED

Kansas

Wherry Pool


Map No. _____ Sec. 7 Twp. 21 R. 6WWell No. 1 DresbackHoll & Branine Company

FIRST REPORT

Contractor

NE/C

SECTION PLAT

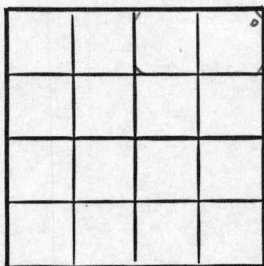330 Ft. from N. Line

_____ Ft. from S. Line

330 Ft. from E. Line

_____ Ft. from W. Line

Rice County

Location X

Rig up _____

Drilling and Remarks:

RECORD

Cased _____ in., _____ ft.

Sand _____

Gas _____

Oil _____

Total Depth _____

PRODUCTION

1st 24 hrs. Nat. _____

1st 24 hrs. after shot _____

Gas _____ Cu. Ft.

Dry Hole _____

Abandoned _____

Date

NOV 10 1948 19S. J. LEWIS Scout

Map No. 48 Sec. 7 Twp. 21 R. 6W

Well No. 1 Dresback

Holl & Branine Company

COMPLETE

Contractor

NE/C

E1.1707
SECTION PLAT

			6

330 Ft. from N. Line

 Ft. from S. Line

330 Ft. from E. Line

 Ft. from W. Line

Rice County

Location

Rig up

Drilling and Remarks:

Cong 3536
5103037
Wine 3534
Pump 25 oil bat
3934

RECORD

Cased in., ft.

Sand

Gas

Oil

Total Depth 3537

PRODUCTION

1st 24 hrs. Nat.

1st 24 hrs. after shot

Gas Cu. Ft.

Dry Hole

Abandoned

Date

DEC 15 1948 19

S. J. LEWIS

Scout