

Rice

DX 78-1


KANSAS

Section 6 Township 21 Range 6W

Well No. #1 Fuller

Company H.C. Bennett

NORTH

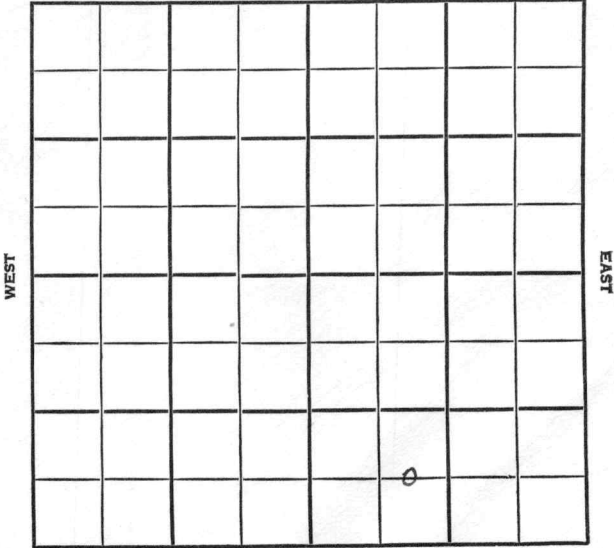

SOUTH

Rice

SEC.	TWP.	R.
6	21	6W

WELL NO. _____

COMPANY #1 Fuller FARM

CONTRACTOR H.C. Bennett


Salina Drlg. Tools.
Welch-Bornholdt Pool NORTH

_____ Ft. from N. Line

660 _____ Ft. from S. Line

_____ Ft. from E. Line

990 _____ Ft. from W. Line

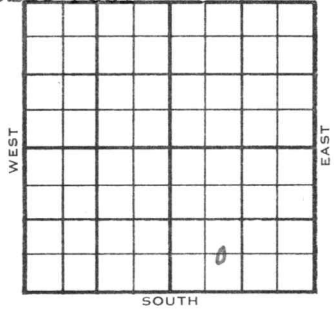

C E/2 SW SE

1954	ELEVATION	REPORT
	1703'	

9/22 Spud 9-13-54
8" @ 152' w/125 sks.
Drlg. 2084'

11/3 Spud 9-13-54 - Oil Well
TD 3565'
8" @ 152'
Cong. 3480', Miss 3510'
TD 3514'
5" @ 3512'
DD 3537'
DD 3552'
FU 75' wtr.
DD 3565'
Sd-frac
Comp. 25 bopd 10% wtr.

COMPLETED

County Rice State Kansas

Sec. 6 (Blk. 21) (Sur. 6W) (Twp.) (Rge.) Map No.

Operator H. C. Bennett

Well No. 1 Farm Fuller

Elev. 1703 Location C E $\frac{1}{2}$ SW SE

660 Ft. From S Line SE

990 Ft. From W Line Quarter

1st. Report

Completion NOV 3 1954

Remarks Welch-Bornholdt Pool

Salina Drlg. - Contr.

Spudding Date 9-13-54

Drlg. Data Oil well TD 3565

8" @ 152 Cong. 3480 Miss. 3510

TD 3514 5" @ 3512 DD 3537 DD 3552

FU 75' wtr. DD 3565 sd-frac

Comp. 25 bopd 10% wtr.

F. BEN GILSTRAP