


Section 6 Township 21 Range 6W

Well No. #1 Turner

Company S G Hall etal.  
Wildcat

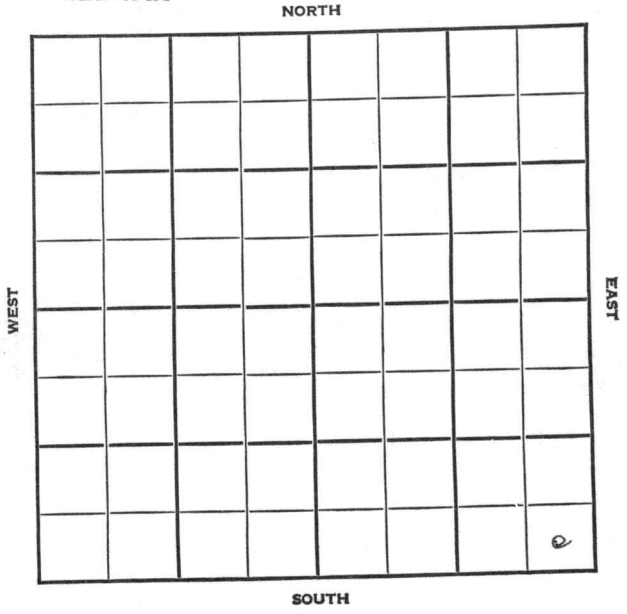

KANSAS

Rice



Sec. 6 Twp. 21 R. 6W

Well No. #1 Turner Farm

S. G. Holl et al Company

Wildcat


         Ft. from N. Line

330' Ft. from S. Line

330' Ft. from E. Line

         Ft. from W. Line

SE/C

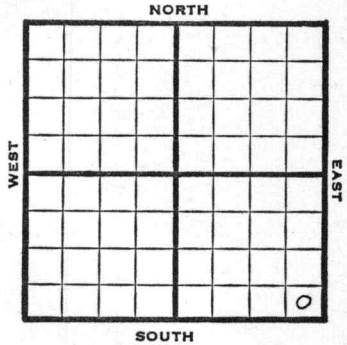

1948

Elev. 1692'

REPORT

- 3/24 8" @ 188'  
WOC
- 3/31 Drlg. 2536'
- 4/7 Conglomerate 3484-85' TD  
TD 3485'  
5" @ 3485'  
RUST
- 4/14 Mississippi 3498'  
TD 3507'  
Swb 2½ bbls oil PH, 8 hrs.
- 4/21 Miss 3498'  
5" @ 3485'  
Pump 40 Pot.  
TD 3507'  
Gr. 360

**COMPLETED**

Kansas

Map No. \_\_\_\_\_ Sec. 6 Twp. 21 R. 6W

Well No. 1 Turner

S. G. Holl etal. Company

FIRST REPORT

Contractor

SE/C


SECTION PLAT

\_\_\_\_\_ Ft. from N. Line

330 Ft. from S. Line

330 Ft. from E. Line

\_\_\_\_\_ Ft. from W. Line

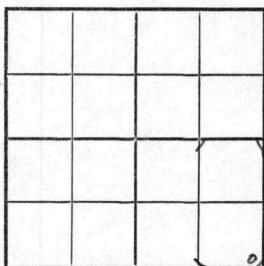

Rice County

Location \_\_\_\_\_

Rig up \_\_\_\_\_

Drilling and Remarks:

8" @ 188 WOC

RECORD

Cased \_\_\_\_\_ in., \_\_\_\_\_ ft.

Sand \_\_\_\_\_

Gas \_\_\_\_\_

Oil \_\_\_\_\_

Total Depth \_\_\_\_\_

PRODUCTION

1st 24 hrs. Nat. \_\_\_\_\_

1st 24 hrs. after shot \_\_\_\_\_

Gas \_\_\_\_\_ Cu. Ft.

Dry Hole \_\_\_\_\_

Abandoned \_\_\_\_\_

Date

MAR 24 1948 19 \_\_\_\_\_ S. J. LEWIS Scout

Map No. 48 Sec. 6 Twp. 21 R. 6W

Well No. 1 Turner

S. G. Holl et al. Company

COMPLETE

Contractor

SE/C

E. J. 1/692

SECTION PLAT


         Ft. from N. Line

330 Ft. from S. Line

330 Ft. from E. Line

         Ft. from W. Line

Rice County

Location                                 

Rig up                                 

Drilling and Remarks:

*Miss 8488  
5" C 8488*

*Pump 40 BT*

*860*

RECORD

Cased          in.,          ft.

Sand                                 

Gas                                 

Oil                                 

Total Depth 3527

PRODUCTION

1st 24 hrs. Nat.                         

1st 24 hrs. after shot                         

Gas                                  Cu. Ft.

Dry Hole                                 

Abandoned                                 

Date

APR 21 1948 19 S. J. LEWIS Scout