

KANSAS ^{KANSAS} ~~KANSAS~~ Rice


Section 6 Township 21 Range 6W

Well No. 2 Turner

Company Holl & Branine

Welch Pool

NORTH

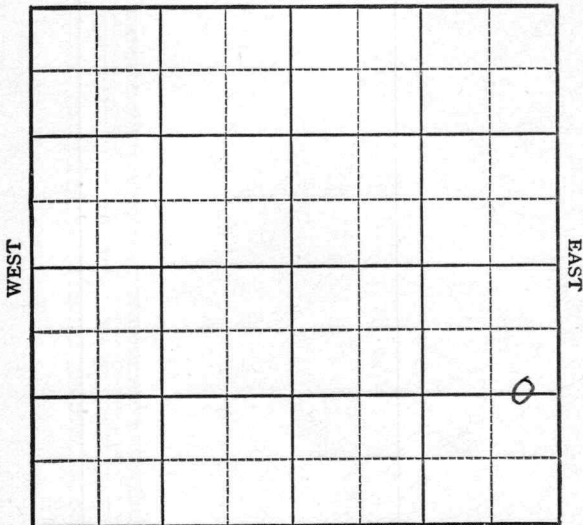

SOUTH

Rice

Sec. 6 **KANSAS** Twp. 21 R. 6W ✓


Well No. #2 Turner Farm
Holl & Branine Company

_____ Ft. from N. Line

1240' Ft. from S. Line

330' Ft. from E. Line

_____ Ft. from W. Line

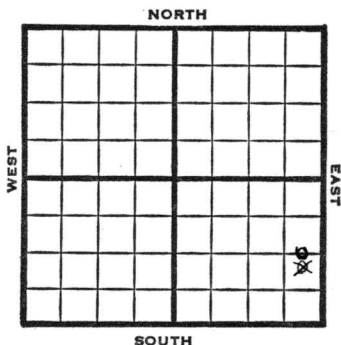

C E L S E

1948

Elev 1682'

R E P O R T

12/15

Location

12/22

8" @ 155'
Drlg. 1582'

12/29

Drlg. 2950'

1/5

Conglomerate 3446'-47'
TD 3447'
5" @ 3447'

1/12

"

1/19

TD 3535'
40 qts 3486'-3504'
CO

1/26

Mississippi 3477'

2/2

TD 3535'
Miss 3477'
5" @ 3447'
40 qts.
Pump 25 oil Pot
40° Gr.
Comp

COMPLETED

Map No. _____ Sec. 6 Twp. 21 R. 6W

Well No. 2 Turner

Holl & Branine Company

FIRST REPORT Contractor

C E L S E

SECTION PLAT

_____ Ft. from N. Line

1240

_____ Ft. from S. Line

330

_____ Ft. from E. Line

_____ Ft. from W. Line

Rice County

Location X

Rig up _____

Drilling and Remarks:

RECORD

Cased _____ in., _____ ft.

Sand _____

Gas _____

Oil _____

Total Depth _____

PRODUCTION

1st 24 hrs. Nat. _____

1st 24 hrs. after shot _____

Gas _____ Cu. Ft.

Dry Hole _____

Abandoned _____

Date

DEC 15 1948

19

S. J. LEWIS

Scout

Map No. 48 Sec. 6 Twp. 21 R. 6W

Well No. 2 Turner

Holl & Branine Company

COMPLETE Contractor

C E L S E

211686

SECTION PLAT

_____ Ft. from N. Line

1240 Ft. from S. Line

330 Ft. from E. Line

_____ Ft. from W. Line

Rice County

Location _____

Rig up _____

Drilling and Remarks:

Misc 3477
5' @ 3477
40 gals.
Pump 25 oil @ 40
40 @ 3477

RECORD

Cased _____ in., _____ ft.

Sand _____

Gas _____

Oil _____

Total Depth 3535

PRODUCTION

1st 24 hrs. Nat. _____

1st 24 hrs. after shot _____

Gas _____ Cu. Ft.

Dry Hole _____

Abandoned _____

Date

FEB 2 1949 19

S. J. LEWIS

Scout