

Section 8 Township 21 Range 6-W

Well No. 1 Waldston "B"

Company Cities Service

Wherry Pool

NORTH

WEST

EAST

							0

SOUTH

Rice

Rice County

✓
X

Sec. 8 Twp. 21 R. 6-W

Well No. 1 Waldston "B" Farm

Cities Service Company


Wherry Pool

330 Ft. from N. Line

Ft. from S. Line

330 Ft. from E. Line

Ft. from W. Line

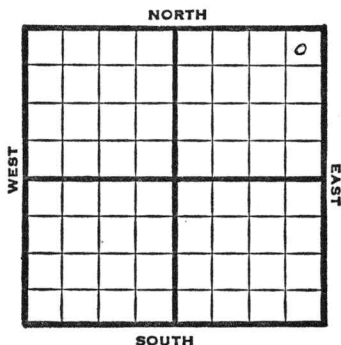

NE/C

1947 Elev. 1659' REPORT

7-16 Loc.

7/22 "

7/29 Drlg. 80'

8/6 8" @ 265'
Drlg 2520'

8/13 Lansing 2903'
Mississippi 3453'
TD 3460'
5" @ 3458'

8/20 "

8/27 TD 3484'
Pump 33 bbls. oil / 7W 24 hrs.

9/3 "

9/10 Miss. 3453'
5" @ 3458'
Pump 33 oil / 7W pot.
38.0 Gr.
TD 3484'

COMPLETED

Map No. _____ Sec. 8 Twp. 21 R. 6W

Well No. 1 Waldston "B"

Cities Service


Company

FIRST REPORT

Contractor

NE/C

SECTION PLAT

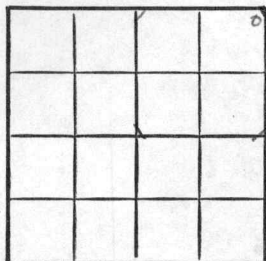

330 Ft. from N. Line

_____ Ft. from S. Line

330 Ft. from E. Line

_____ Ft. from W. Line

Rice County

Location X

Rig up _____

Drilling and Remarks:

RECORD

Cased _____ in., _____ ft.

Sand _____

Gas _____

Oil _____

Total Depth _____

PRODUCTION

1st 24 hrs. Nat. _____

1st 24 hrs. after shot _____

Gas _____ Cu. Ft.

Dry Hole _____

Abandoned _____

Date

JUL 16 1947

19

S. J. LEWIS

Scout

Map No. 48 Sec. 8 Twp. 21 R. 6W

Well No. 1 Waldston "B"

Cities Service

Company

COMPLETE

Contractor

NE/C

E1.1659

SECTION PLAT

			o

330 Ft. from N. Line

Ft. from S. Line

330 Ft. from E. Line

Ft. from W. Line

Rice County

Location

Rig up

Drilling and Remarks:

Miss 3453

5" @ 3458

Prod 33 oil + 1W

OS

OS 3/4

RECORD

Cased _____ in., _____ ft.

Sand _____

Gas _____

Oil _____

Total Depth 3484

PRODUCTION

1st 24 hrs. Nat. _____

1st 24 hrs. after shot _____

Gas _____ Cu. Ft.

Dry Hole _____

Abandoned _____

Date

SEP 10 1947 19

S. J. LEWIS Scout