
FORM 51

Rice KANSAS

Section 7 Township 21 Range 6 W

Well No. # 1 Drescheck

Company H. C. Bennett

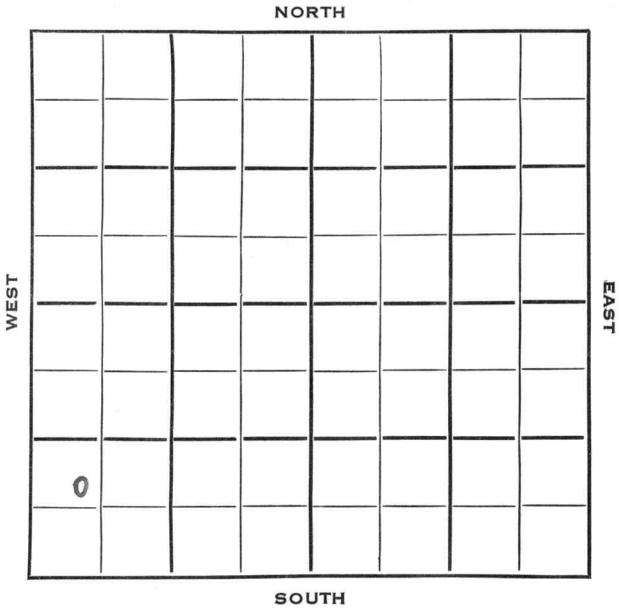

Rice KANSAS

| SEC. | TWP. | R. |
|---|---|---|
| 7 | 21 | 6W |

WELL NO.

1 Drescheck FARM

COMPANY

H. C. Bennett

CONTRACTOR

Mallard Drlg.


_____ Ft. from N. Line

840 Ft. from S. Line

_____ Ft. from E. Line

400 Ft. from W. Line

NW SW SW

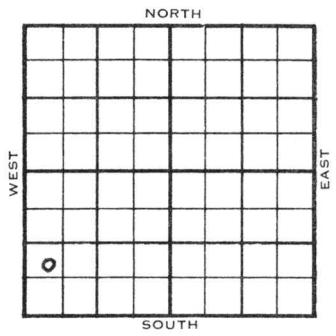


| 1953 | ELEVATION 1662' REPORT |
|---|---|
| 11/24 | MIR |
| 12/9 | 8" @ 168'<br>Cong 3470', Miss 3480'<br>RTD 3483'<br>5" @ 3481' |
| 12/16 | CO 3483 FU 850' oil & wtr.<br>S/1 BO & 2 BWPH 4 hrs. DP |
| 1954 | |
| 5/12 | Spud 11-26-53<br>Oil Well<br>TD 3497'<br>8" @ 168'<br>Cong. 3470', Miss 3480'<br>TD 3483'<br>5" @ 3481'<br>CO to 3483'<br>FU 850' oil<br>S/1 bo 2 bwph 4 hrs. DD 3484<br>S/1 bo 1½ bwph 4 hrs.<br>P/5 bo 15 bwpd<br>P/3 bo 10 bwpd - DD 3488' 1½ go 6 bw 24 hrs.<br>DD 3497'<br>Sd-frac<br>P/12 bopd<br>Comp. 12 bopd COMPLETED |

DX-78

FORM 275 FOR SALE BY KANSAS BLUE PRINT CO.


County Rice State Kansas

Sec. 7 (Blk. Twp.) 21 (Sur. Rge.) 6W Map No.

Operator H. C. Bennett

Well No. 1 Farm Dresheck

Elev. Location NW SW SW

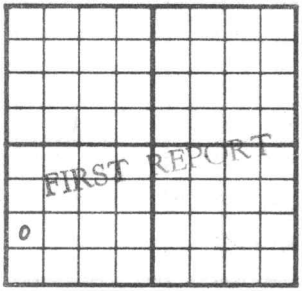


840 Ft. From S Line SW

400 Ft. From W Line Quarter

1st. Report NOV 24 1953

Completion

Remarks Mallard Drlg. - Contr.

Spudding Date

Drlg. Data

M I R

J. G. McGEHEE

FORM 275 FOR SALE BY KANSAS BLUE PRINT CO.


County Rice State Kansas

Sec. 7 (Blk. / Twp.) 21 (Sur. / Rge.) 6W Map No.

Operator H. C. Bennett

Well No. 1 Farm Dresheck

Elev. 1662 Location NW SW SW

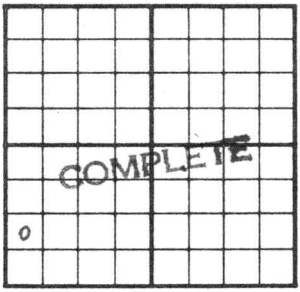


840 Ft. From S Line SW

400 Ft. From W Line Quarter

1st. Report

Completion MAY 12 1954

Remarks

Mallard Drlg. - Contr.

Spudding Date 11-26-53

Drlg. Data Oil well TD 3497

8" @ 168 Cong. 3470 Miss. 3480

TD 3483 5" @ 3481 CO to 3483

FU 850' oil, S/ 1 bo 2 bwph 4 hr.

DD 3484 S/ 1 bo 1½ bwph 4 hr.

P/ 5 bo 15 bwpd P/ 3 bo 10 bwpd

DD 3488 1½ bo 6 bw 24 hr. DD 3497

sd-frac P/ 12 bopd Comp. 12 bopd

J. G. McGEHEE