

KANSAS

Butler

Section 25 Township 25 Range 3EWell No. 1 HinnenCompany Rex & Morris et al

Misc.

NORTH

							0

SOUTH

WEST EAST

KANSAS

Butler

Sec. 25 Twp. 25 R. 3E

Well No. #1 Hunnen Farm

Rex & Morris et al

Company

Miscellaneous (Rex & Morris, Cont.)

Ft. from N. Line


330'

Ft. from S. Line

330'

Ft. from E. Line

Ft. from W. Line

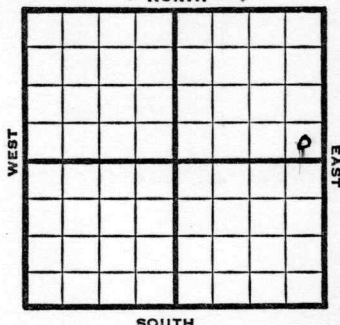

SE NE

SOUTH

1949	lev 1274'	REPORT
5/25	Location	
6/1	Drlg. 120'	
6/7	15" @ 165	
	Drlg 750'	
6/15	Drlg. 1480'	
	13" @ 890'	
6/21	10" @ 1600'	
	8" @ 2100'	
	Drlg. 2185'	
6/28	Miss 2662'	
	TD 2664'	
	7" @ 2653'	
7/6	TD 2664'	
	1000 acid	
7/13	TD 2664	
	Miss 2662'	
	7" @ 2653'	
	1000 acid	
	Pump 35 Oil Pot	
	38° Gr.	
	Comp	
	COMPLETED	

Kansas

Miscellaneous

Map No. _____ Sec. 25 Twp. 25 R. 3EWell No. 1 Hinnen

Rex & Morris etal. _____ Company

Rex & Morris _____ Contractor


SE NE

FIRST REPORT
SECTION PLAT

_____ Ft. from N. Line

330 Ft. from S. Line330 Ft. from E. Line

_____ Ft. from W. Line

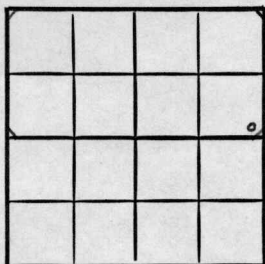

Butler County

Location X

Rig up _____

Drilling and Remarks:

RECORD

Cased _____ in., _____ ft.

Sand _____

Gas _____

Oil _____

Total Depth _____

PRODUCTION

1st 24 hrs. Nat. _____

1st 24 hrs. after shot _____

Gas _____ Cu. Ft.

Dry Hole _____

Abandoned _____

Date


MAY 25 1949 19S. J. LEWIS Scout

Kansas

Map No. K13 Sec. 25 Twp. 25 R. 3EWell No. 1 HinnenRex & Morris etal. Company**COMPLETE**

Contractor

SE NE

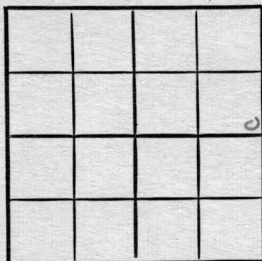E1,1274
SECTION PLATFt. from N. Line330 Ft. from S. Line330 Ft. from E. LineFt. from W. Line

Butler County

RECORD

Location _____

Cased _____ in., _____ ft.

Rig up _____

Sand _____

Drilling and Remarks:

Gas _____

Oil _____

Total Depth 2664**PRODUCTION**

1st 24 hrs. Nat. _____

1st 24 hrs. after shot _____

Gas _____ Cu. Ft.

Dry Hole _____

Abandoned _____

Date

JUL 13 1949

19

S. J. LEWIS Scout