FORM 51


Butler

KANSAS

Section 25 Township 25 Range 3 E

Well No. # 2 Hinnen

Company Kewanee Oil

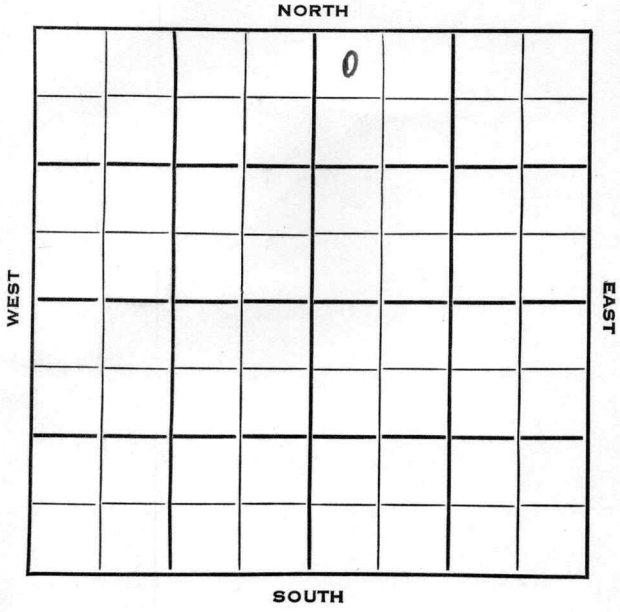

FORM 252-B

Butler KANSAS

Sec. 25 Twp. 25 R. 3E

Well No. #2 Hinnen Farm

Kewanee Oil Company

Wixson Contractor


330 Ft. from N. Line

Ft. from S. Line

Ft. from E. Line

330 Ft. from W. Line

NW NW NE

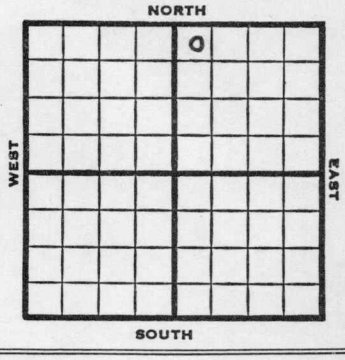

1953	Elev. 1279' REPORT
7/1	MICT
8/26	Spud 7-7-53 Oil Well TD 2670' 20" @ 41' 15" @ 166' 13" @ 940' 10" @ 1750' 8" @ 2038' KC 2190', Miss 2661, 7" @ 2656' TD 2670' Comp. 10 bopd. 20 bw.

COMPLETED

FORM 275 FOR SALE BY KANSAS BLUE PRINT CO.


County Butler State Kansas

Sec. 25 (Blk. Twp.) 25 (Sur. Rge.) 3E Map No.

Operator Kewanee Oil

Well No. 2 Farm Hinnen

Elev. Location NW NW NE

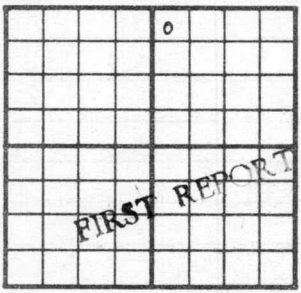

330 Ft. From N Line NE

330 Ft. From W Line Quarter

1st. Report JUL 1 1953

Completion

Remarks

Wixson - Contr.

Spudding Date

Drlg. Data

MICT

J. G. McGEHEE

FORM 275 FOR SALE BY KANSAS BLUE PRINT CO.


County Butler State Kansas

Sec. 25 (Blk. Twp.) 25 (Sur. Rge.) 3E Map No.

Operator Kewanee Oil

Well No. 2 Farm Hinnen

Elev. 1279 Location NW NW NE

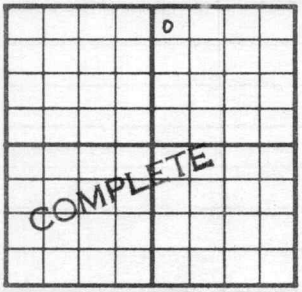

330 Ft. From N Line NE

330 Ft. From W Line Quarter

1st. Report

Completion AUG 26 1953

Remarks

Wixson & Contr.

Spudding Date 7-7-53

Drlg. Data Oil well TD 2670

20" @ 41 15" @ 166 13" @ 940

10" @ 1750 8" @ 2038 KC 2190

Miss. 2661 7" @ 2656 TD 2670

Comp. 10 bopd 20 bw

J. G. McGEHEE