

Map No. KANSAS Sec. 10 Twp. 21 R. 6^w


Well No. 1-Brown Farm
Mid-Field Oil & Roy company

330 Ft. from N. Line

_____ Ft. from S. Line

330 Ft. from E. Line

_____ Ft. from W. Line

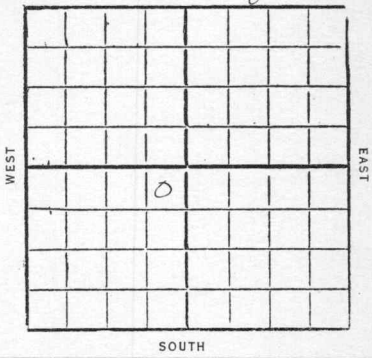

1931

Date	REPORT
8/19	Log
8/26	Log
9/2	Log run up
9/9	Log
9/16	Spdy 270'
9/23	Wrlg 830'
9/30	12 1/2" - 903
10/7	Wrlg 1515'
10/14	10" - 1810'
10/21	Wrlg 2200'
10/28	HFW 2330
	drlg 2445
11/4	" 2840'
11/10	6" - 2870
	Wrlg 2925'
11/18	HFW 2955-65
	HFW 2983-3003
	T.D. 3011 UIR 6"
11/24	6" - 3011
	drlg 3035'
12/2	HFW 3100-15
	drlg 3170'

12/19. Dreg up VLR lug 3190
12/16- 6"-3141
dreg 3200'
12/22. Rng 5"-3425'
12/30- Chat 3456-82
SD. 3482' HFW
1932
1/6 —
1/13 —
1/20 —
1/27- Cased 5"-3425
Chat 3456-82
T.D. 3482' HFW
Dreg & Abandon

Rice

KANSAS

Map No. 48 Sec. 10 Twp. 21 R. 6^W

Well No. 1 Brown

Mid-Field Oil & Royalty Co. Company

Contractor

FIRST REPORTS


SECTION PLAT

330 Ft. from N. Line

Ft. from S. Line

330 Ft. from E. Line

Ft. from W. Line

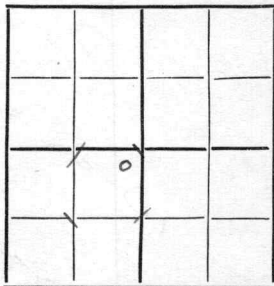

Location

Rig up Roy

Drilling and Remarks:

RECORD

Cased in., ft.

Sand

Gas

Oil

Total Depth

PRODUCTION

1st 24 hrs. Nat.

1st 24 hrs. after shot

Gas Cu. Ft.

Dry Hole

Abandoned

Date

AUG 19 1931

CHAS. L. SHERWOOD

Rice

48 KANSAS

Map No. _____ Sec. 10 Twp. 21 R. 6 W

Well No. 1 Brown

Miss. Field Oil & Royalty Company

Contractor

COMPLETED

SECTION PLAT

330 Ft. from N. Line

_____ Ft. from S. Line

330 Ft. from E. Line

_____ Ft. from W. Line

	o		

ABANDONED

Location _____

Rig up _____

Drilling and Remarks:

RECORD

Cased 5" in., 3475 ft.

Sand Chat 3456-82

Gas HF W

Oil _____

Total Depth 3482 ft

PRODUCTION

1st 24 hrs. Nat. _____

1st 24 hrs. after shot _____

Gas _____ Cu. Ft.

Dry Hole

Abandoned

Date

JAN 27 1932 19

CHAS. L. SHERWOOD Scout