


# KANSAS

DX 78-1 Rice

Section 8 Township 21 Range 6W

Well No. #3 Walsten Est

Company Henry Bennett

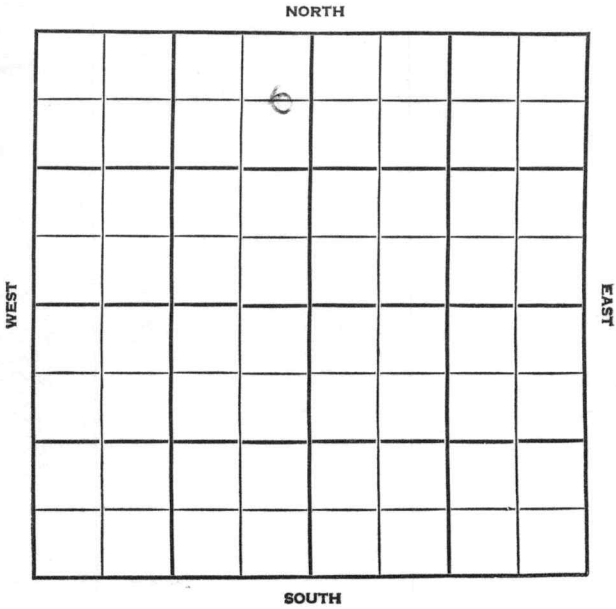

Rice

KANSAS

SEC. 8	TWP. 21	R. 6W
-----------	------------	----------

WELL NO.

#3 Walsten Est.

FARM

COMPANY

Henry Bennett

CONTRACTOR

Salina Drlg.


Welch-Bornhold

\_\_\_\_\_ Ft. from N. Line

\_\_\_\_\_ Ft. from S. Line

\_\_\_\_\_ Ft. from E. Line

\_\_\_\_\_ Ft. from W. Line

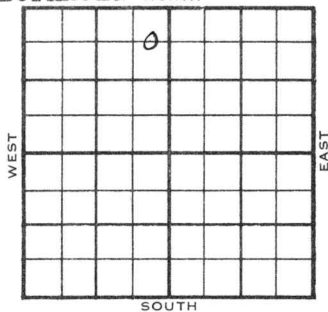

C E 1/2 NE NW

CSO - FO

1956	ELEVATION 1675'	REPORT
------	--------------------	--------

3-21 Location

5-29

Comm. 3-23-56  
 8 5/8" @ 220 w/175  
 5 1/2" @ 350 w/75  
 DD 3505  
 Comp. 20 bopd, 7 bw  
 H. 2732', Tr. 2751', Dg. 2755',  
 L. 2940', C. Shly 3445', Cg.Chert 3486  
 Miss. 3500'.  
 TD 3503'

COMPLETED

County Rice Elev. \_\_\_\_\_  
 Sec. 8 Twp. 21 Rge. 6W  
 Company Henry Bennett  
 Farm Name Walsten Est. No. 3

TOPS	DEPTH	LOG	DATUM
Anh.			
Tp.			
H.			
Tr.			
Dg.			
Bl.			
L.			
K.C.			
B.K.C.			
Ce.			
C.			
M.			
M.			
K.			
Mz.			
Mq.			
V.			
S.			
S.			
A.			
R.			
Pe.			
G.			
T.D.			

Loc. in Sec. C E 1/2 NE NW  
 Geol. \_\_\_\_\_  
 Contr. \_\_\_\_\_  
Salina Drlg.  
 Pool Welch-Bornhold



Date Comm. \_\_\_\_\_ CSO - FO  
 Location \_\_\_\_\_  
 \_\_\_\_\_  
 \_\_\_\_\_  
 \_\_\_\_\_  
 \_\_\_\_\_  
 \_\_\_\_\_  
 \_\_\_\_\_  
 \_\_\_\_\_  
 \_\_\_\_\_  
 \_\_\_\_\_

Co.  
Lse.  
No.  
Sec.  
T.  
R.

County Rice Elev. 1675  
 Sec. 8 Twp. 21 Rge. 6W  
 Company Henry Bennett  
 Farm Name Walsten Est. No. 3

TOPS	DEPTH	LOG	DATUM
Anh.			
Tp.			
H.	<u>2732</u>		
Tr.	<u>2751</u>		
Dg.	<u>2755</u>		
Bl.			
L.	<u>2940</u>		<u>1265</u>
K.C.			
B.K.C.			
Ce.			
C.	<u>3445</u>		<u>1770</u>
M.	<u>3486</u>		<u>1811</u>
M.	<u>3500</u>		<u>1825</u>
K.			
Mz.			
Mq.			
V.			
S.			
S.			
A.			
R.			
Pf.			
G.			
T.D.	<u>3503</u>		

Loc. in Sec. \_\_\_\_\_  
C E  $\frac{1}{2}$  NE NW  
 Geol. \_\_\_\_\_  
 Contr. \_\_\_\_\_  
Salina Drl  
 Pool \_\_\_\_\_  
Welch-Bornhol



Date Comm. 3-23-56 MAY 29 1956  
8 5/8" @ 220/175 5 1/2" @ 350/75  
DD 3505 Comp. 20 bopd 7 bw

Co.  
 Use  
 No.  
 Sec.  
 T.  
 R.