


Section 7 Township 25 Range 3E
 Well No. 2 Chaney
 Company Eckland Drlg.

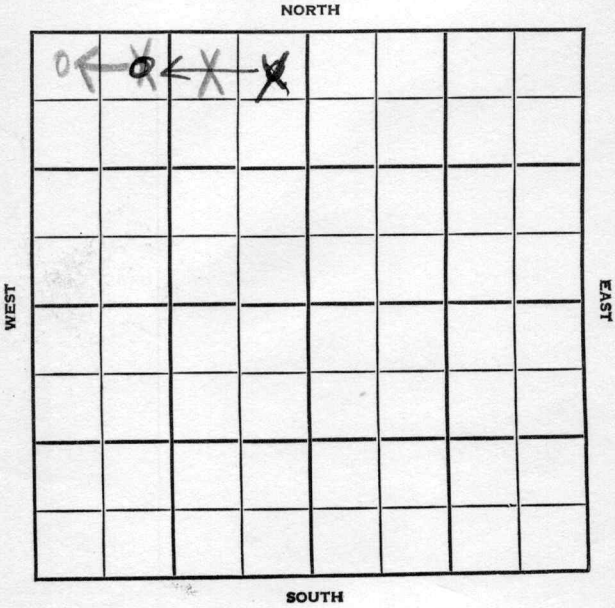

Butler

KANSAS

SEC.	TWP.	R.
7	25	3E

WELL NO.

#2 Chaney

FARM

COMPANY

Eckland Drlg.

CONTRACTOR

Ca Tools.

McCann Pool

330

Ft. from N. Line

Ft. from S. Line


~~330~~

Ft. from E. Line

330

992

Ft. from W. Line

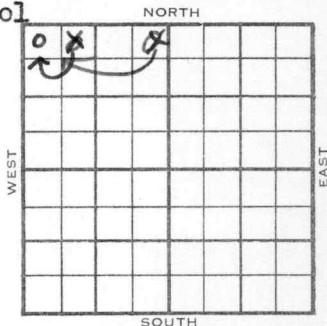

NW NW
NE NE NW

ELEVATION

REPORT

1955

1344'

4/20

RUR

6/8

Somm. 5-2-55

8-5/8" @ 93 w/70 5 1/2" @ 2790/50

DD 2800 SSO 600' wtr. PB 2778

20/2769-71 FU 350' oil 12 hr. frac.

Comp. 25 BOPD 3 BW

Burg 2765-88' M. 2789'

TD 2791'

COMPLETED

County Butler State KansasSec. 7 (Blk. Twp.) 25 (Sur. Rge.) 3E Map No.Operator Eckland Drlg.Well No. 2 Farm ChaneyElev. Location NE NE NW

330 Ft. From N Line NW330 Ft. From E Line Quarter1st. Report APR 20 1955

Completion

Remarks

Co. tools

Spudding Date

Drlg. Data McCann PoolRUR

FABEN GILSTRAP

SCOUT TICKET

DX-201

Kansas

SEC.

7

TWP.

25

R.

3E

WELL NO.

2 Chaney

FARM

COMPANY

Eckland Drlg.

CONTRACTOR

CORRECTION

NE NW NW

330

FT. FROM N. LINE


FT. FROM S. LINE

FT. FORM E. LINE

990

FT. FROM W. LINE

NORTH

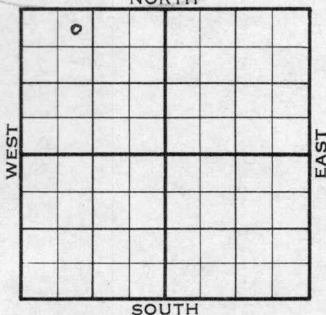

Butler County

☐

LOCATION

☐

RIG UP

DRILLING AND REMARKS:

Reported

NE NE NW

RECORD

CASED IN., FT.

SAND

GAS

OIL

TOTAL DEPTH

PRODUCTION

1ST 24 HRS. NAT.

1ST 24 HRS. AFTER SHOT

GAS CU. FT.

DRY HOLE

ABANDONED

DATE

APR 27 1955

SCOUT

FABEN GILSTRAP

County Butler ✓ Elev. 1344
 Sec. 7 Twp. 25 Rge. 3E
 Company Eckland Drlg.
 Farm Name Chaney No. 2

TOPS	DEPTH	LOG	DATUM	Loc. in Sec.
Anh. <u>Burg</u>	<u>2765-88</u>		<u>1421</u>	<u>C NE NW</u>
Tp.				<u>NW NW NW</u>
H.				
Tr.				
Dg.				
B.L.				
L.				
K.C.				Geol. _____
B.K.C.				Contr. _____
Ce.				
C.				
M.	<u>2789</u>		<u>1445</u>	Pool _____
M.				
K.				
Mz.				
Mq.				
V.				
S.				
S.				
A				
R.				
Pe.				
G.				
T.D.	<u>2791</u>			

correct to 1421

COMPLETE
 JUN 8 '55

Date Comm. 5-2-558 5/8" @ 93/70 5 1/2" @ 2790/50DD 2800 SS0 600' wtr. PB 277820/ 2769-71 FU 350' oil 12 hr.frac Comp. 25 bopd 3 bw

First reported as NE NE NW 4-20-55
Corrected to NE NW NW 4-27-55
Completion shows C NE NW. 6-8-55

Which is correct? Advise.

Thanks.

Mickey

*The operator says it's
NWNWNW so I guess
they're all wrong.*

Scout Cards *mm*

Land Small Map

Land Wall Map

Tracings

France Map

Pierce Map

Misc.

JUN 29 1955