


Rice

Map No. Kansas Sec. 11 Twp. 21 R. 6^W

Well No. 1 Swanson Farm
Yankee et al Company

200 Ft. from N. Line
 _____ Ft. from S. Line
990 Ft. from E. Line
 _____ Ft. from W. Line

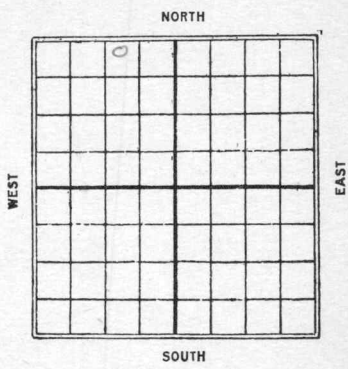

Date	REPORT
1926	
3/17	Location
4/14	_____
4/21	_____
4/29	Rig
5/5	Rig - tools.
5/12	Rigging
5/26	Spud & S.P.
6/2	same
6/19	_____
6/16	_____
6/23	_____
6/30	S.D.
7/14	_____
7/21	_____
8/11	T.D. 450 - S.D.
8/18	D/G 860
8/25	" 1200
9/1	" 1700
9/8	" 1920
9/15	" 2200
9/22	" 2560
9/29	" 2800

10/6 - No report
10/13 - Drly 2900'
10/20 - Drly 3100'
10/27 - T.D. 3100 - U.P.
11/3 - T.D. 3100 - U.P. 6"
11/10 - Drly 3240'
11/17 - Top chat 3388 - S.D.
engine repairs
11/24 - Same
12/1 —————
12/8 - T.D. 3406' - S.D.
12/15 - Same
12/21 —————
12/29 —————
1927
1/5 - Abandoned 3444

Map No. KANSAS Sec. 11 Twp. 21 R. 6 W

Well No. 1 Swanson

Walsten Miller Sycamore Company
Contractor

SECTION PLAT

200 Ft. from N. Line

_____ Ft. from S. Line

990 Ft. from E. Line

_____ Ft. from W. Line

ABANDONED

	0		

Location _____

Rig up _____

Drilling and Remarks:

Top Chat 3407
TD 3444 MFW
D & F.

RECORD

Cased _____ in., _____ ft.

Sand _____

Gas _____

Oil _____

Total Depth _____

PRODUCTION

1st 24 hrs. Nat. _____

1st 24 hrs. after shot _____

Gas _____ Cu. Ft.

Dry Hole _____

Abandoned _____

Date

JAN 5 1927

S. J. LEWIS

Map No. **KANSAS** Sec. 11 Twp. 21 R. 6 W

Well No. Swanson

Yorker & Dal Company

Contractor

SECTION PLAT

200 Ft. from N. Line

----- Ft. from S. Line

990 Ft. from E. Line

----- Ft. from W. Line

	0		

FIRST REPORTS

Location -----

Rig up -----

Drilling and Remarks:

Location

RECORD

Cased ----- in., ----- ft.

Sand -----

Gas -----

Oil -----

Total Depth -----

PRODUCTION

1st 24 hrs. Nat. -----

1st 24 hrs. after shot -----

Gas ----- Cu. Ft.

Dry Hole -----

Abandoned -----

Date

MAR 17 1966

S. J. LEWIS

Scout

Rice

MAP NO. KANSAS SEC. 11 TWP. 7 1/2 R. 6w

WELL NO. no 1 Swanson

Yonker

COMPANY

CONTRACTOR

oil check out

SECTION PLAT

ABANDONED

_____ FT. FROM N. LINE

_____ FT. FROM S. LINE

_____ FT. FROM E. LINE

_____ FT. FROM W. LINE

O.K.

LOCATION _____

RIG UP _____

DRILLING AND REMARKS:

RECORD

CASED _____ IN., _____ FT.

SAND _____

GAS _____

OIL _____

TOTAL DEPTH 3444

PRODUCTION

1ST 24 HRS. NAT. _____

1ST 24 HRS. AFTER SHOT _____

GAS _____ CU. FT.

DRY HOLE

ABANDONED

DATE

7/11 192 7

SCOUT