FORM 51 25M 3-49 PETROL


KANSAS

Butler

Section 9 Township 25 Range 3-E

Well No. #1 Neiman

Company R. J. Wixson & B & R Drlg.

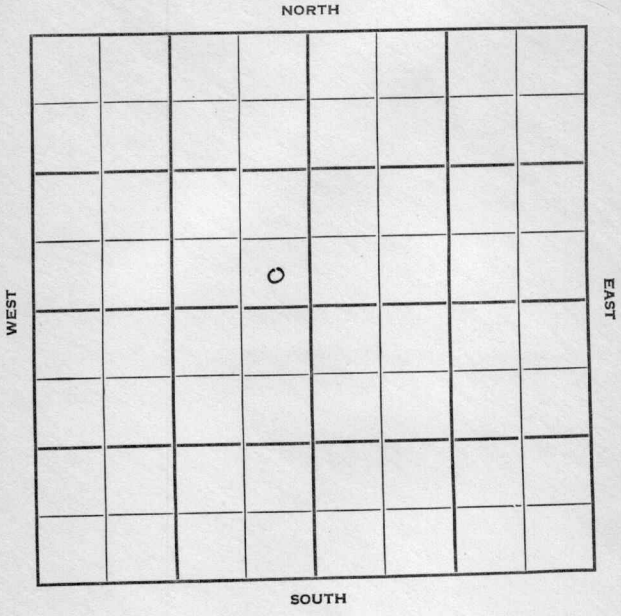

FORM 252-B
10M 9-49 PETROL

Butler KANSAS


Sec. 9 Twp. 25 R. 3E

Well No. #1 Neiman Farm

R. J. Wixson & B & R Drlg. Company

Contractor

Wildcat

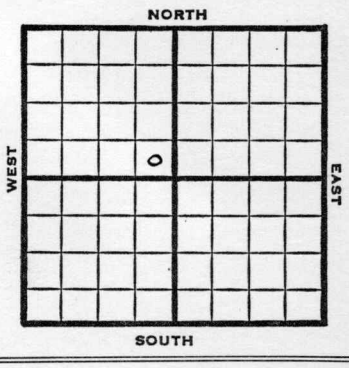

____ Ft. from N. Line

330' Ft. from S. Line

330' Ft. from E. Line

____ Ft. from W. Line

SE SE NW

1950	Elev 1364	REPORT
6/14	Rig up	
7/26	15½" @ 90	
	13" @ 1505	
	10" @ 1685	
	Lans 2060	Miss 2757
	5" @ 2757	
	TD 2805	
	D&A	
	ABANDONED	

Form 26 200 Bks. 11-49 Petrol Kansas Wildcat

Map No. _____ Sec. 9 Twp. 25 R. 3E

Well No. 1 Neiman

R. J. Wixson & B & R Drlg. Company

_____ Contractor

SE SE NW

_____ Ft. from N. Line


330 Ft. from S. Line

330 Ft. from E. Line

_____ Ft. from W. Line

Butler County

SECTION PLAT

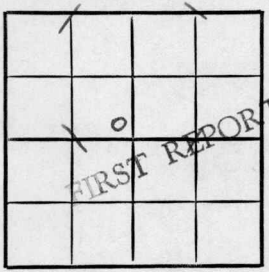

Location _____

Rig up x

Drilling and Remarks:

RECORD

Cased _____ in., _____ ft.

Sand _____

Gas _____

Oil _____

Total Depth _____

PRODUCTION

1st 24 hrs. Nat. _____

1st 24 hrs. after shot _____

Gas _____ Cu. Ft.

Dry Hole _____

Abandoned _____

Date

JUN 14 19 J. E. TYRA Scout

Form 26 200 Bks. 11-49 Petrol

Kansas

Map No. _____ Sec. 9 Twp. 25 R. 3E

Well No. 1 Neiman


R. J. Wixson & B & R Drlg. Company

Contractor

SE SE NW

El. 1364

SECTION PLAT

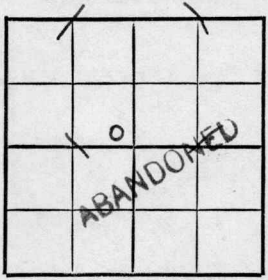

_____ Ft. from N. Line

330 Ft. from S. Line

330 Ft. from E. Line

_____ Ft. from W. Line

Butler County

Location _____

Rig up _____

Drilling and Remarks:

15½" @ 90

13" @ 1050

10" @ 1685

Lans. 2060

Miss. 2757

5" @ 2757

TD 2805

RECORD

Cased _____ in., _____ ft.

Sand _____

Gas _____

Oil _____

Total Depth 2805

PRODUCTION

1st 24 hrs. Nat. _____

1st 24 hrs. after shot _____

Gas _____ Cu. Ft.

Dry Hole _____

Abandoned _____

Date D & A

JUL 26 1950 19

J. E. TYRA Scout