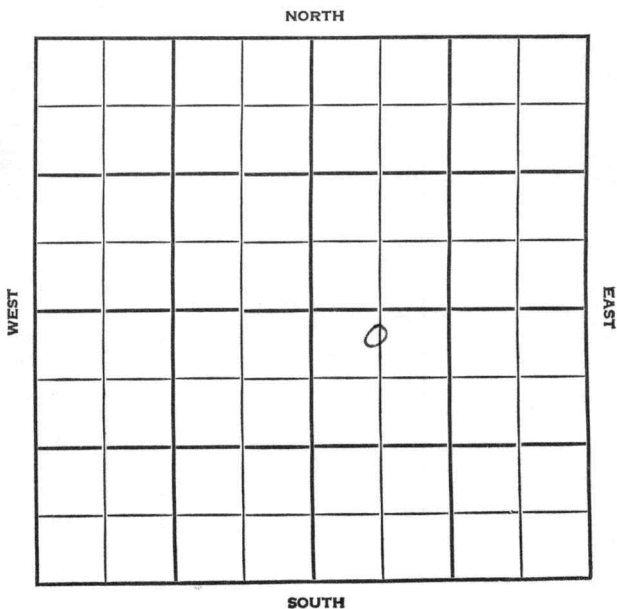


Section 2 Township 21 Range 7WWell No. #1 JohnsonCompany Thos. Allan & CRA

Rice

KANSAS

SEC.	TWP.	R.
2	21	7 W

WELL NO.

1 Johnson

FARM

COMPANY

Thos. Allan & C R A

CONTRACTOR

Allan

N. Wherry Pool

330


Ft. from N. Line

Ft. from S. Line

Ft. from E. Line

660

Ft. from W. Line

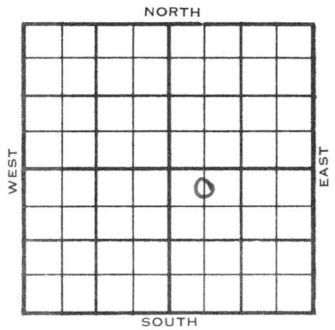C N $\frac{1}{2}$ NW SE

1955

ELEVATION

REPORT

3/23

Location

County Rice State Kansas

Sec. 2 (Blk.) 21 (Sur.) 7W Map No.

Operator Thos. Allan & C R A

Well No. 1 Farm Johnson

Elev.	Location	C N $\frac{1}{2}$ NW SE
-------	----------	-------------------------

330 Ft. From N Line SE

660 Ft. From W Line Quarter

1st. Report MAR 23 1955

Completion

Remarks

Allen - Contr.

Spudding Date _____

Drig. Data N. Wherry Pool

Location