
FORM 51

Butler KANSAS

Section 10 Township 25 Range 3 E

Well No. # 4 Ulmer

Company Wixon et al

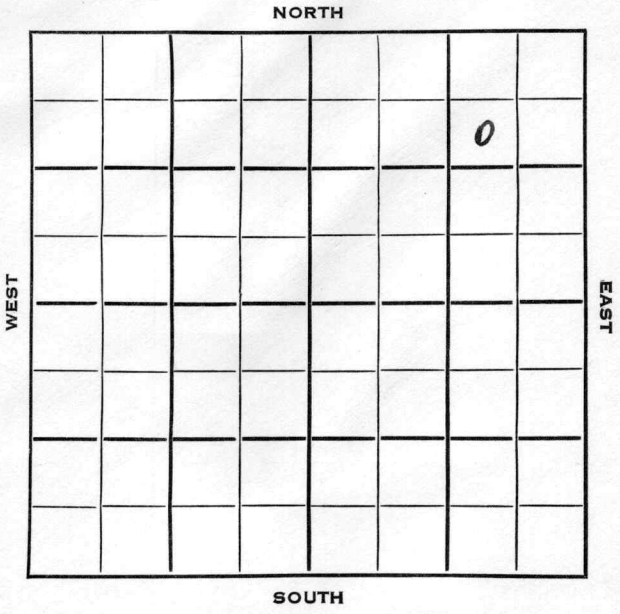

Butler

FORM 252-B

KANSAS

Sec. 10 Twp. 25 R. 3E

Well No. #4 Ulmer Farm

Wixon et al Company

Wixon Contractor

Potwin Pool


990 Ft. from N. Line

Ft. from S. Line

990 Ft. from E. Line

Ft. from W. Line

SW NE NE

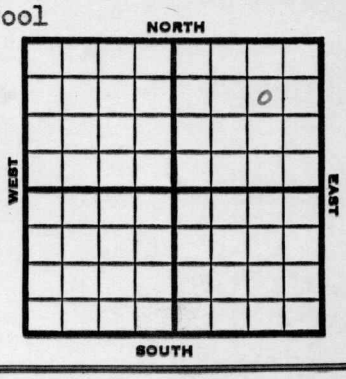

1953	REPORT
	Elev. 1343'
8/5	Location
9/23	Spud 8-1-53 Oil well TD 2740 15" @ 90 13" @ 145 10" @ 168 8" @ 2204 B KC 2430 5" @ 2720 TD 2740 Cong. 2710 22 GO 17 GW 9 hr. 1000 A Miss 2720 Comp. 20 BOPD

COMPLETED

FORM 275 FOR SALE BY KANSAS BLUE PRINT CO.

County Butler State Kansas

Sec. 10 (Blk. Twp.) 25 (Sur. Rge.) 3E Map No.

Operator Wixon etal.

Well No. 4 Farm Ulmer

Elev. Location SW NE NE



990 Ft. From N Line NE

990 Ft. From E Line Quarter

1st. Report 4116 5 1953

Completion

Remarks

Wixon - Contr.

Spudding Date

Drlg. Data Potwin Pool

Location

J. G. McGEHEE

FORM 275 FOR SALE BY KANSAS BLUE PRINT CO.


County Butler State Kansas

Sec. 10 (Blk. Twp.) 25 (Sur. Rge.) 3E Map No.

Operator Wixon etal.

Well No. 4 Farm Ulmer

Elev. 1343 Location SW NE NE

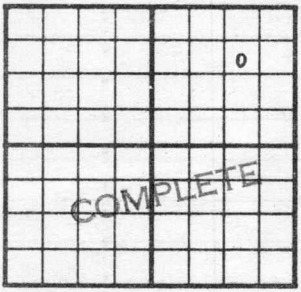

990 Ft. From N Line NE

990 Ft. From E Line Quarter

1st. Report

Completion SEP 23 1953

Remarks Potwin Pool
Wixon - Contr.

Spudding Date 8-1-53

Drlg. Data Oil well TD 2740

15" @ 90 13" @ 145 10" @ 1685

8" @ 2204 B KC 2430 5" @ 2720

TD 2740 Cong. 2710 22 go 17 gw 9 hr.

1000 A Miss. 2720

Comp. 20 bopd

J. G. McGEHEE