


Rice Co.,
KANSAS

Section 1 Township 21 Range 7W

Well Number 1 Brothers

Company Dickey Oil

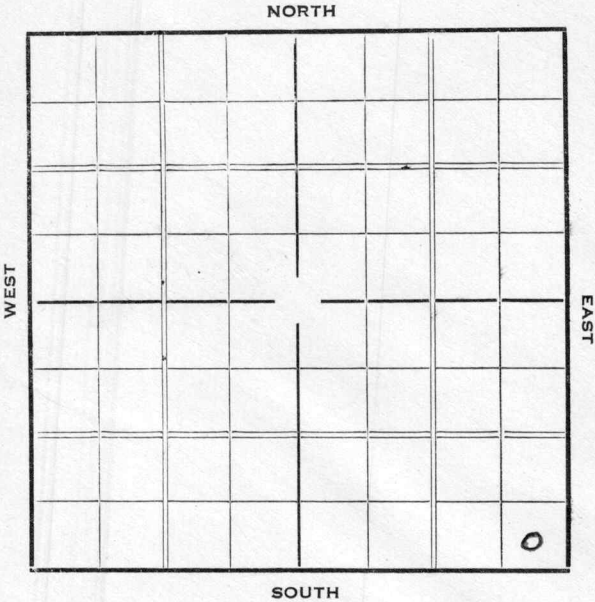

SOUTH

COMPLETED

KANSAS

Map No. 49 Sec. 1 Twp. 21 R. 24Well No. 1 BrothersDickey Oil Company

Contractor

SECTION PLAT

			6

 Ft. from N. Line330 Ft. from S. Line330 Ft. from E. Line Ft. from W. Line

FIRST REPORT

Location Rig up

Drilling and Remarks:

Rig

RECORD

Cased in., ft.Sand Gas Oil Total Depth

PRODUCTION

1st 24 hrs. Nat. 1st 24 hrs. after shot Gas Cu. Ft.Dry Hole Abandoned

Date

DEC 2 1936 19

S. J. LEWIS Scout

Map No. 49 Sec. 1 Twp. 21 R. 7W

Well No. 1 Brothers

Hickey Oil Company

Contractor

SECTION PLAT

			0

 Ft. from N. Line

330 Ft. from S. Line

330 Ft. from E. Line

 Ft. from W. Line

ABANDONED

Location

Rig up

Drilling and Remarks:

Chas 3488.

Water

D & A

RECORD

Cased in., ft.

Sand

Gas

Oil

Total Depth 3504

PRODUCTION

1st 24 hrs. Nat.

1st 24 hrs. after shot

Gas Cu. Ft.

Dry Hole

Abandoned

Date

JAN 27 1937

19

S. J. LEWIS

Scout