


Map No. KANSAS Sec. 33 Twp. 21 R. 6^W *Rice*
Well No. 15 Sharp Farm
Labor of Coleman Company

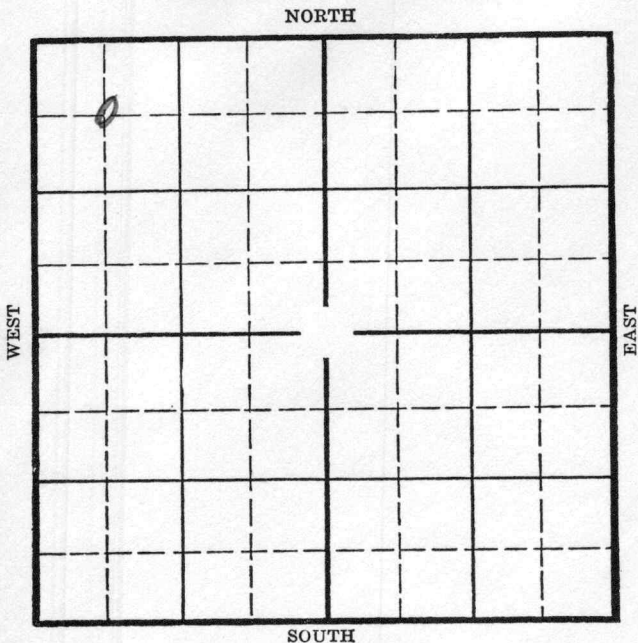

Location _____
Drilling Remarks _____

RECORD

Cased _____ in. _____ ft.
Sand _____
Gas _____
Oil _____
Total Depth _____

Rig Up _____
Drilling Remarks _____

PRODUCTION

1st 24 hrs. Nat. _____
1st 24 hrs. after shot _____
Gas _____ cu. ft. _____
Dry Hole _____
Abandoned _____

Rice
6 W

Map No. Sec. 33 Twp. 21 R. 6

Well No. 1- Sharp Farm
Zabor & Coleman Company


660 Ft. from N. Line

 Ft. from S. Line

 Ft. from E. Line

660 Ft. from W. Line

Elevation 1657

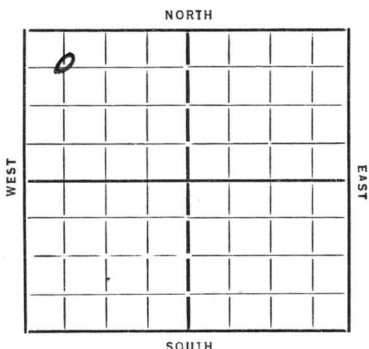

REPORT

~~1935~~
11/20 Location
11/29 Rig
12/6 10" 156
12/3 Dlg 1775
12/19 " 3050 Lancing 2925
12/26 log pipe 3225
12/36
1/10 Shot off pipe 3152
 Dlg Rig
1/17 Setting whipstock 3026
1/24 Dlg 3495
1/31 Top Chat 3584
 Top Viola 3952
 Top Simp 4000
 T.D. 4072 TD 4097
2/5 Lil 4072
 TD 4097
 D. & F.

ABANDONED

KANSAS

Rice
 Map No. *48* Sec. *33* Twp. *21* R. *6W*

Well No. *1-T Harp*
Tabor & Coleman Company

Contractor

FIRST REPORTS

SECTION PLAT

<i>0</i>			

660 Ft. from N. Line

Ft. from S. Line

Ft. from E. Line

660 Ft. from W. LineLocation *✓*

Rig up

Drilling and Remarks:

RECORD

Cased.....in.,ft.

Sand.....

Gas.....

Oil.....

Total Depth.....

PRODUCTION

1st 24 hrs. Nat.....

1st 24 hrs. after shot.....

Gas.....Cu. Ft.

Dry Hole.....

Abandoned.....

Date

ORVAL MANNSCHRECK

11-20-35 192.....

Scout

Map No. 48 Sec. 33 Twp. 21 R. 6W

Well No. 1 - Sharp

Taher & Coleman Company

Contractor

SECTION PLAT

660 Ft. from N. Line

..... Ft. from S. Line

..... Ft. from E. Line

660 Ft. from W. Line

COMPLETED

0			

Location.....

Rig up.....

Drilling and Remarks:

NO & A

RECORD

Cased..... in., ft.

Sand 516 4072

Gas.....

Oil.....

Total Depth 4097

PRODUCTION

1st 24 hrs. Nat.....

1st 24 hrs. after shot.....

Gas..... Cu. Ft.

Dry Hole.....

Abandoned.....

Date

FEB 5 1936

192

ORVAL MANNSCHRECK

Scout