FORM 51 25M 3-49 PETROL


Butler

KANSAS

Section 10 Township 25 Range 3E

Well No. #2 Ulmer

Company Wickson et al

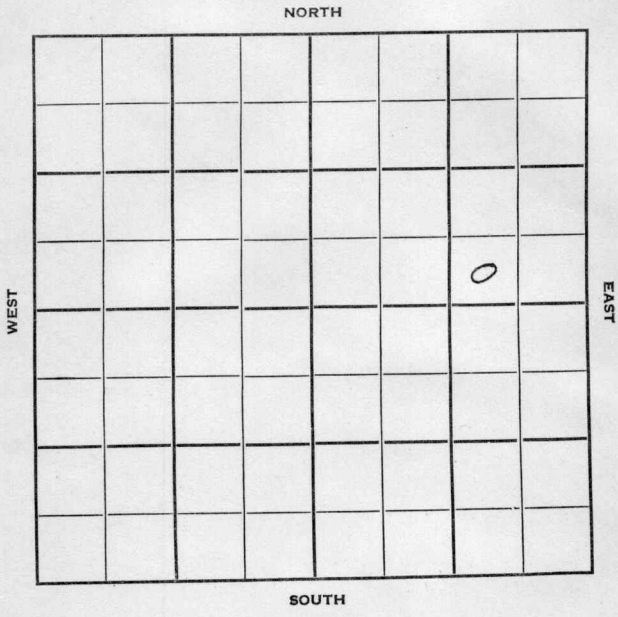

FORM 252-A
5M 10-48 PETROL


Butler KANSAS

Sec. 10 Twp. 25 R. 3E

Well No. #2 Ulmer Farm

Wickson et al Company

Miscellaneous

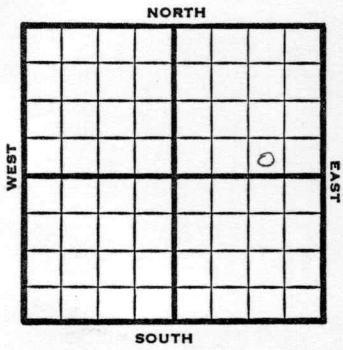

_____ Ft. from N. Line

330' Ft. from S. Line

990' Ft. from E. Line

_____ Ft. from W. Line

SW SE NE

1950	Elev. 1332' REPORT
1/18	RUR
2/22	12" @ 85' 10" @ 1649' 8" @ 2174' 5½" @ 2731' Lans 2003' Miss 2728 D&A TD 2798'

ABANDONED

Form 26 200 Bks. 6-49 Petrol

Kansas

Miscellaneous

Map No. _____ Sec. 10 Twp. 25 R. 3E

Well No. 2 Ulmer

Wickson etal. Company

Contractor

SW SE NE

SECTION PLAT



_____ Ft. from N. Line

330 Ft. from S. Line

990 Ft. from E. Line

_____ Ft. from W. Line

Butler County

Location

Rig up

Drilling and Remarks:

R U R

RECORD

Cased _____ in., _____ ft.

Sand

Gas

Oil

Total Depth

PRODUCTION

1st 24 hrs. Nat.

1st 24 hrs. after shot

Gas _____ Cu. Ft.

Dry Hole

Abandoned

Date

JAN 18 1950 19

J. E. TYRA Scout

Form 26 200 Bks. 11-49 Petrol

Kansas

Miscellaneous

Map No. _____ Sec. 10 Twp. 25 R. 3E

Well No. 2 Ulmer

Wickson etal. Company

Contractor

SW SE NE

El. 1332

SECTION PLAT



_____ Ft. from N. Line

330 Ft. from S. Line

990 Ft. from E. Line

_____ Ft. from W. Line

Butler County

Location _____

Rig up _____

Drilling and Remarks:

12" @ 85'
10" @ 1649
8" @ 2174
5½ @ 2731
Lans 2003
miss 2728
D&A

RECORD

Cased _____ in., _____ ft.

Sand _____

Gas _____

Oil _____

Total Depth 2798

PRODUCTION

1st 24 hrs. Nat. _____

1st 24 hrs. after shot _____

Gas _____ Cu. Ft.

Dry Hole _____

Abandoned _____

Date

FEB 22 1950 19

J. E. TYRA Scout