
Rice KANSAS

SECTION 2 TOWNSHIP 21 RANGE 7W

WELL NO. #5 Oden

COMPANY Tom Allen & CRA

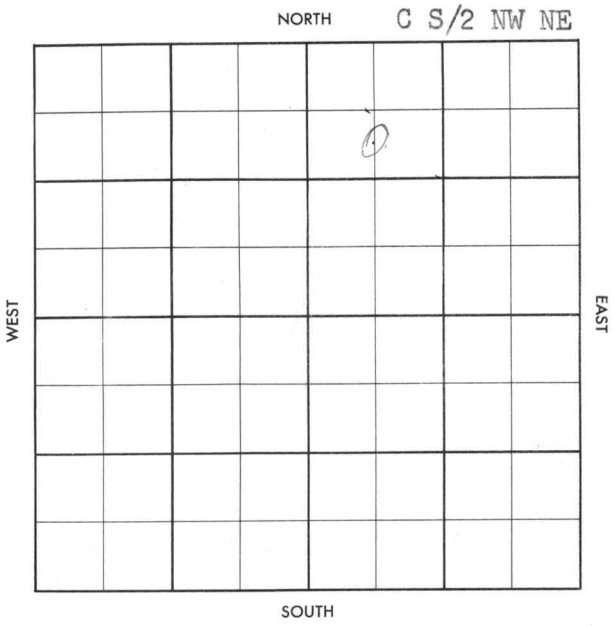

FORM 504-3 SUNRAY

FORM 513 SUNRAY

County Rice Elev. 1667

Sec. 2 Twp. 21 Rge. 7W

Company Tom Allen & C. R. A.

Farm Name Oden No. 5

TOPS	DEPTH	LOG	DATUM
Anh.			
Tp.			
H.			
Tr.			
Dg.			
Bl.			
L.	2970		
K.C.			
~~B.K.C.~~ Surveyed	3422		
Ce.			
C.			
M.	3451		
M.			
K.			
Mz.			
Mo.			
V.			
S.			
S.			
A			
R.			
P€.			
G.			
T.D.	3423		

Loc in Sec. C S/2 NW NE

Geol.

Contr. Allan Tools

Pool Wherry

MAY 29 '57

COMPLETE

Co. Lse. No. Sec. T. R.

Date Comm.

Location APR 10 '57 4-3-57 8 5/8

162/150 ID 2765 APR 17 '57

5½ 3423 / APR 24 '57 DD 3431

tst 1½ Bwph + Tr. oil &

1 BF (99% oil) DD 3451 DD

3466 & 1 BFph 50% wtr

PE Liner to 3466? POP MAY 1 '57

MAY 8 '57 MAY 15 '57 P. 9 Bopd + 9 Bwpd

MAY 22 '57 MAY 29 '57 P. 15 Bopd + 15

Bwpd

FORM 513 SUNRAY

County Rice Elev.

Sec. 2 Twp. 21 Rge. 7W

Company Tom Allen & C. R. A.

Farm Name Oden No. 5

TOPS	DEPTH	LOG	DATUM
Anh.			
T.P.			
H.			
Tr.			
Dg.			
B.L.			
L.			
K.C.			
B.K.C.			
Ce.			
C.			
M.			
M.			
K.			
Mz.			
Mo.			
V.			
S.			
S.			
A			
R.			
P€.			
G.			
T.D.			

Loc. in Sec. C S/2 NW NE

Geol.

Contr. Allan Tools

Pool Wherry

APR 8 '57

FIRST REPORT

Date Comm.

Location

12

Co. Lse. No. Sec. T. R.