
FORM 51 5M PETROL

KANSAS Rice

Section 10 Township 21 Range 6W

Well No. 3 Brown

Company H. C. Bennett etal

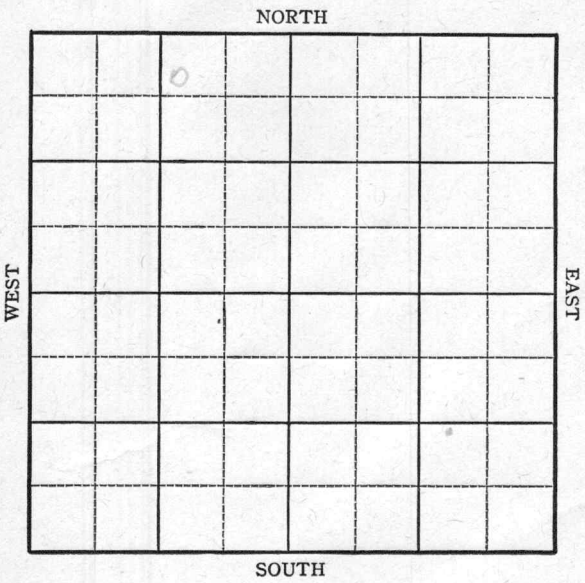

FORM 252-A
5M 8-45 PETROL

KANSAS Rice

Sec. 10 Twp. 21 R. 6-W

Well No. #3 Brown Farm


H. C. Bennett et al Company

500 Ft. from N. Line

Ft. from S. Line

1275 Ft. from E. Line

Ft. from W. Line

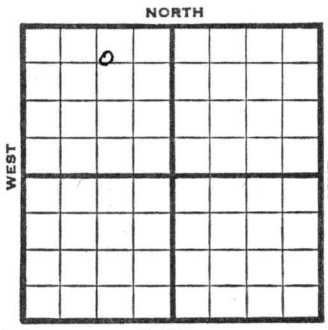

C W L NE NW Elev. 1595

1945	REPORT
9/5	10" @ 165' Drlg. 1940'
9/12	Drlg. 2830'
9/19	Miss. 3421-3425 TD 3425 SO Run csg.
9/26	7" @ 3423 RUST
10/3	" " "
10/10	" " "
10/17	" " "
10/24	TD 3439 600' oil plus 200' wtr.
10/31	TD 3441
11/7	" "
11/14	Miss. 3421 7" @ 3423 TD 3441' Pump 100 Pot. Grav. 36.0

COMPLETED

FORM 26 200 BKS 1-41 PETROL

KANSAS

Kansas Pool Name Welch

Map No. 48 Sec. 10 Twp. 21 R. 6W

Well No. 3 Brown

H. C. Bennett etal Company

FIRST REPORT Contractor

C W L NE NW


500 Ft. from N. Line

Ft. from S. Line

1275 Ft. from E. Line

Ft. from W. Line

SECTION PLAT

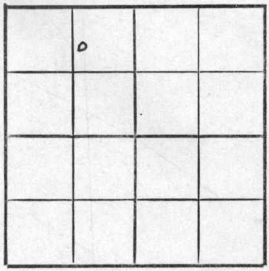

Rice County

Location

Rig up

Drilling and Remarks:

10"-165
1940

RECORD

Cased in., ft.

Sand

Gas

Oil

Total Depth

PRODUCTION

1st 24 hrs. Nat.

1st 24 hrs. after shot

Gas Cu. Ft.

Dry Hole

Abandoned

Date

SEP 5 1945 19 S. J. LEWIS Scout

FORM 26 200 BKS 1-44 PETROL

KANSAS

Kansas Pool Name Welch Pool

Map No. 48 Sec. 10 Twp. 21 R. 6W

Well No. 3 Brown


H. C. Bennett etal. Company

COMPLETED Contractor

C W L NE NW

E 1,1585

SECTION PLAT

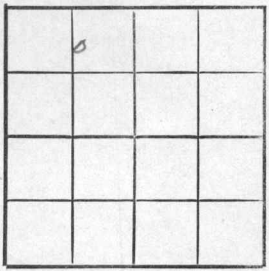

500 Ft. from N. Line

Ft. from S. Line

1275 Ft. from E. Line

Ft. from W. Line

Rice County

Location

Rig up

Drilling and Remarks:

Mic 3421

7" @ 3423

Pump 100 BO

36 - 1/2

RECORD

Cased in., ft.

Sand

Gas

Oil

Total Depth 3441

PRODUCTION

1st 24 hrs. Nat.

1st 24 hrs. after shot

Gas Cu. Ft.

Dry Hole

Abandoned

Date

NOV 14 1945 19

S. J. LEWIS Scout