

KANSAS

FORM 51 25M 3-49 PETROL

Rice

Section 15 Township 21 Range 6W


Well No. 1 Burdick

Company Pabco Drlg. et al
Welch

NORTH

WEST

EAST

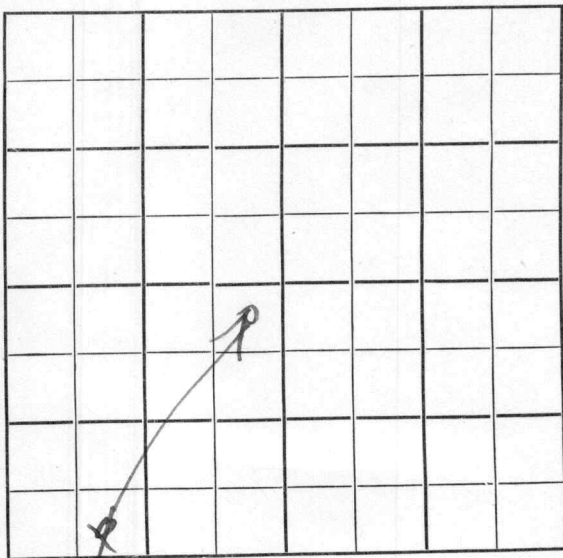

SOUTH

Rice

KANSAS



Sec. 15 Twp. 21 R. 6W

Well No. #1 Burdick Farm

Pabco Drlg. et al Company


Welch Pool

330' Ft. from N. Line

_____ Ft. from S. Line

330' Ft. from E. Line

_____ Ft. from W. Line

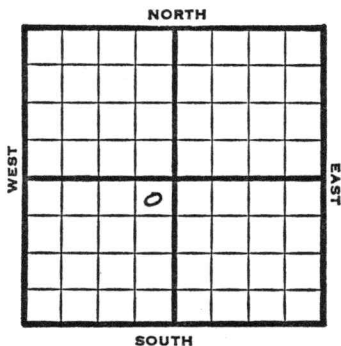

NE SW

1949

REPORT

7/20

Heebner 2712'

Lans. 2916'

Miss 3506'

TD 3546'

D&A

FIRST REPORT

ABANDONED

Kansas

Welch Pool

Map No. _____ Sec. 15 Twp. 21 R. 6WWell No. 1 Burdick

Pabco Drlg. etal. _____ Company

Contractor

NE SW

FIRST REPORT

SECTION PLAT

ABANDONED

330 Ft. from N. Line

_____ Ft. from S. Line

330 Ft. from E. Line

_____ Ft. from W. Line

Rice County

RECORD

Location _____

Cased _____ in., _____ ft.

Rig up _____

Sand _____

Drilling and Remarks:

Gas _____

Heebner 2712

Oil _____

Lans. 2916

Total Depth 3546

Miss. 3506

TD 3546

B & A

PRODUCTION

1st 24 hrs. Nat. _____

1st 24 hrs. after shot _____

Gas _____ Cu. Ft.

Dry Hole _____

Abandoned _____

Date

JUL 20 1949

19

S. J. LEWIS

Scout