

Rice County

Wherry Pool


FORM 51 IOM 12-46 PETROL

KANSAS

Section 2 Township 21 Range 7W

Well No. 3 Leonard

Company Hinkle & Franco

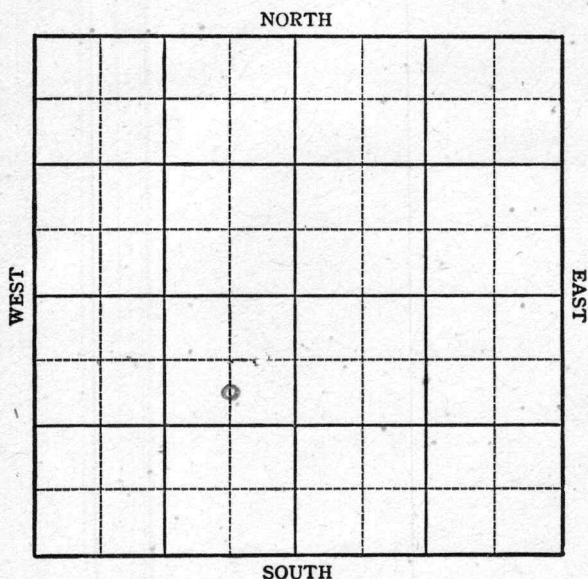

KANSAS

Rice

Sec. 2 Twp. 21 R. 7-W

Well No. #3 Leonard Farm

Hinkle & France Company


Wherry Pool

990 Ft. from N. Line

 Ft. from S. Line

660 Ft. from E. Line

 Ft. from W. Line

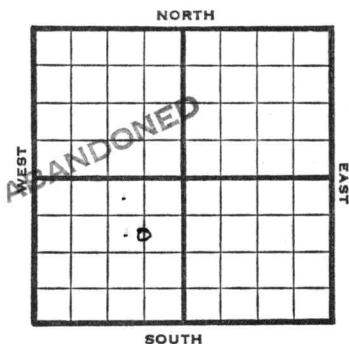

699 L NE-SW

1947 Elev. 1629' REPORT

3/5 8" @ 105'
Drlg 438'

3/11 DDrlg 2830'

3/26 Miss. 3391'
TD 3399'

ABANDONED

KANSAS

Wherry Pool

Map No. 49 Sec. 2 Twp. 21 R. 7WWell No. 3 LeonardHinkle & Franco CompanyFIRST REPORT Contractor

C S L NE SW

SECTION PLAT

990 Ft. from N. Line Ft. from S. Line660 Ft. from E. Line Ft. from W. LineRice CountyLocation Rig up

Drilling and Remarks:

8" @ 105

drlg. 438

RECORD

Cased in., ft.Sand Gas Oil Total Depth

PRODUCTION

1st 24 hrs. Nat. 1st 24 hrs. after shot Gas Cu. Ft.Dry Hole Abandoned

Date

MAR 5 1947 19S. J. LEWIS Scout

Kansas

Map No. 1549 Sec. 2 Twp. 21 R. 7WWell No. 3 LeonardHinkle & Franco CompanyABANDONED Contractor

C S L NE SW

5/1/628
SECTION PLAT990 Ft. from N. Line Ft. from S. Line660 Ft. from E. Line Ft. from W. Line

Rice County

Location Rig up

Drilling and Remarks:

Miss 3391

RECORD

Cased in., ft.Sand Gas Oil Total Depth 3399

PRODUCTION

1st 24 hrs. Nat. 1st 24 hrs. after shot Gas Cu. Ft.Dry Hole Abandoned

Date

MAR 26 1947 19S. J. LEWIS

Scout