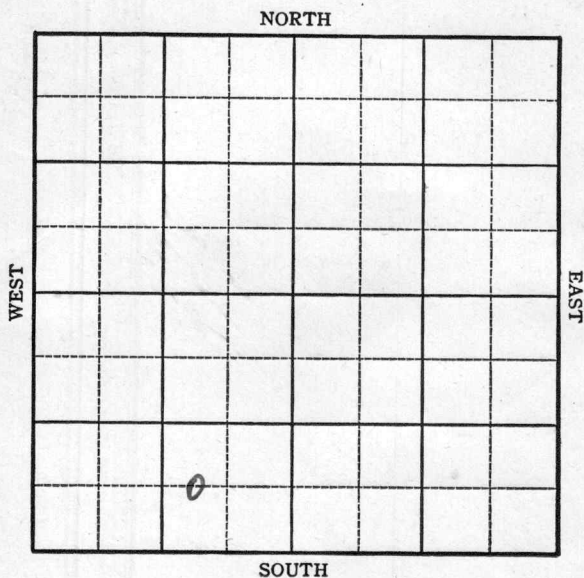


Rice

KANSASSection 2 Township 21 Range 7-WWell No. #1 LeonardCompany Hinkle & Franco Central

KANSAS

Rice County

Sec. 2 Twp. 21 R. 7W

Well No. #1 Leonard Farm

Hinkle & France Central Company


Wherry

 Ft. from N. Line

660 Ft. from S. Line

990 Ft. from E. Line

 Ft. from W. Line

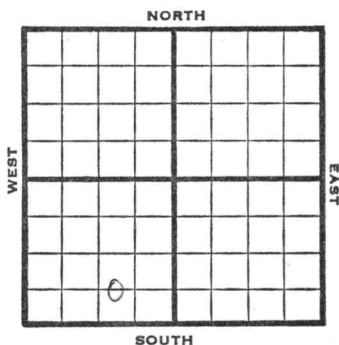

CWL SE SW

1945

REPORT

Elev. 1624

12/28

Location

1946

1/10

10" - 89' Drlg. 1486'

1/17

Miss 3374-83' T.D.

5" - ~~3377'~~ ^{3375'} RUST.

1/24

5" - 3375' (Corrected)

RUST.

1/31

"

2/7 T.D. 3383' 1250' oil in 3 hours.

2/13

Miss. 3374

5" @ 3375

TD 3383'

Pump 50 Pot.

Grav. 39

COMPLETED

KANSAS Kansas Pool Name WherryMap No. 15-49 Sec. 2 Twp. 21 R. 7WWell No. 1 LeonardHinkle & Franco Central Company

FIRST REPORT

Contractor

C W L SE SW

SECTION PLAT

 Ft. from N. Line660 Ft. from S. Line990 Ft. from E. Line Ft. from W. Line

Rice County

Location XRig up

Drilling and Remarks:

RECORD

Cased in., ft.Sand Gas Oil Total Depth

PRODUCTION

1st 24 hrs. Nat. 1st 24 hrs. after shot Gas Cu. Ft.Dry Hole Abandoned

Date

DEC 28 1945

19

S. J. LEWIS

Scout

KANSAS

Kansas Pool Name WherryMap No. 49 Sec. 2 Twp. 21 R. 7WWell No. 1 LeonardHinkle and Franco Central Company

COMPLETED

Contractor

E. H. 1624

C W L SE SW

SECTION PLAT

	0		

Ft. from N. Line

660

Ft. from S. Line

990

Ft. from E. Line

Ft. from W. Line

Rice County

Location _____

Rig up _____

Drilling and Remarks:

Miss 33745" 03375.Pump 50 87374

RECORD

Cased _____ in., _____ ft.

Sand _____

Gas _____

Oil _____

Total Depth 3383

PRODUCTION

1st 24 hrs. Nat. _____

1st 24 hrs. after shot _____

Gas _____ Cu. Ft.

Dry Hole _____

Abandoned _____

Date

FEB 13 1946 19

S. J. LEWIS Scout