

Map No. Sec. Twp. R.

Well No. Farm


..... Company

..... Ft. from N. Line

..... Ft. from S. Line

..... Ft. from E. Line

..... Ft. from W. Line

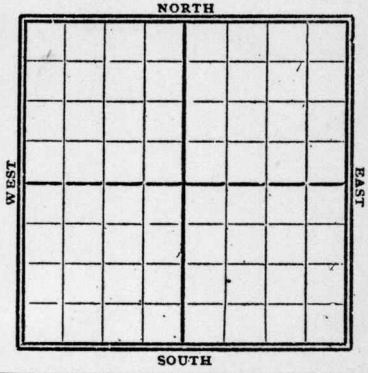

1922

Date

REPORT

Gypsy Records

9/18

*sand 2694-96
Est 4 bbls oil
Abd T.D. 2737'*

K13 MAP NO. KANSAS SEC. 1 TWP. 25S R. 3E

Butler

WELL NO. 1 M.C. Corner

Prairie COMPANY

CONTRACTOR

ABANDONED

SECTION PLAT

	0		

_____ FT. FROM N. LINE

_____ FT. FROM S. LINE

_____ FT. FROM E. LINE

_____ FT. FROM W. LINE

ox

RECORD

LOCATION _____

CASED _____ IN. _____ FT.

RIG UP _____

SAND _____

DRILLING AND REMARKS:

GAS _____

*Hand 26 gal-96
Est 4 bbls*

OIL _____

TOTAL DEPTH 2737

PRODUCTION

1ST 24 HRS. NAT. _____

1ST 24 HRS. AFTER SHOT _____

GAS _____ CU. FT.

DRY HOLE _____

ABANDONED _____

DATE

9/18 1922

SCOUT