

Map No. 2 Sec. 2 Twp. 7 R. 1

Well No. 1 Leonard Farm

Company

NORTH

WEST

EAST

SOUTH

Location

Drilling Remarks

Rig Up.....

Drilling Remarks

RECORD

Cased _____ in. _____ ft.

Sand.....

Gas

Oil_____

Total Depth.....

PRODUCTION

1st 24 hrs. Nat.-----

1st 24 hrs. after shot_____

Gas _____ cu. ft. _____


Dry Hole.....

Abandoned_____

Rice

Map No. 2 Sec. 21 Twp. 7 R. W
Well No. 1 *Leonard* Farm
Harden et al Company

 Ft. from N. Line
330 Ft. from S. Line
 Ft. from E. Line
330 Ft. from W. Line

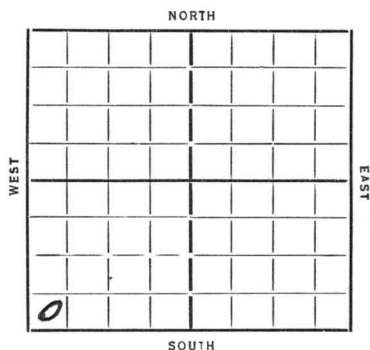

Date 1934 REPORT

11/21 *Cellar*
11/28
12/6 *Material*
12/13 — 12/21 — 12/27 — 1/3/35 —
1/10 — 1/17 — 1/24 — 1/31 —
2/7 — 2/14 — 2/21 — 2/28 —
3/7 *Rig*
3/14
3/21 *Alg 255*
3/28 " 455 15" 411
4/4 " 1459
4/14 " 2190
4/18 13" 1763 10" 2400 *Alg 2630*
4/26 *Asphalt 2885*
14FW 2885-90 8" 2890 *AK 8"*
5/2 *Alg 3127* 8" 3025
5/9 " 3250 8" 3171
5/16 TC 3375 T1 3375 1/2
S.O.R.
5/23 *(OVER)*
5/29 3382 6" 3377
6/6 T1 3382 *flo 732 Hble*

6/12 Chat 3375
T 3382
flow 732 Bbls

COMPLETED

KANSAS

Map No. 49 Sec. 2 Twp. 21 R. 7WWell No. 1- LeonardGarden et al Company

Contractor

FIRST REPORTS

SECTION PLAT

0			

Ft. from N. Line

330 Ft. from S. Line

Ft. from E. Line

330 Ft. from W. Line

Location

Rig up

Drilling and Remarks:

RECORD

Cased _____ in., _____ ft.

Sand _____

Gas _____

Oil _____

Total Depth _____

PRODUCTION

1st 24 hrs. Nat. _____

1st 24 hrs. after shot _____

Gas _____ Cu. Ft.

Dry Hole _____

Abandoned _____

Date

ORVAL MANNSCHRECK

11-21-34 192

Scout

Map No. 49 Sec. 2 Twp. 21 R. 7WWell No. 1- Leonard
Barden et al Company

Contractor

COMPLETED

SECTION PLAT

0			

Ft. from N. Line

330 Ft. from S. Line

Ft. from E. Line

330 Ft. from W. Line

Location

Rig up

Drilling and Remarks:

RECORD

Cased in., ft.

Sand Chat 3375

Gas

Oil

Total Depth 3382

PRODUCTION

1st 24 hrs. Nat.

1st 24 hrs. after shot

Gas Cu. Ft.

Dry Hole

Abandoned

Date

6-12-35 192

ORVAL MANNSCHECK

Scout