

Map No. Sec

Well No.

Sec.

Twp.

R.

Farm

Company

NORTH

A 6x6 grid with dashed lines. A small circle is located in the top-left cell. The grid is labeled 'WEST' on the left, 'EAST' on the right, and 'SOUTH' at the bottom.

Location

Drilling Remarks

Rig Up

Drilling Remarks

RECORD

Cased _____ in. _____ ft.

Sand

Gas

Oil_____

Total Depth-----

PRODUCTION

1st 24 hrs. Nat.-----

1st 24 hrs. after shot-----

Gas _____ cu. ft. _____

Dry Hole.....

Abandoned.....

Butler


Map No. KANSAS Sec. 1 Twp. 25 R. 3E
Well No. 1-C Mc Cramer Farm
Vickers Pet. Company

660 Ft. from N. Line

_____ Ft. from S. Line

_____ Ft. from E. Line

440 Ft. from W. Line

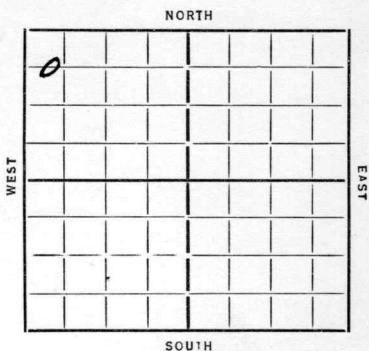

Date 1935

REPORT

1/9 Machine
1/17 Dlg 405
1/24 " 960
1/31 " 1474
2/7 Dlg 1730 10" 1395
2/14 " 2075
2/21 " 2480 8" 2140
2/28 2668
3/7 314
3/21 TL 2710 5" 2712 Pay 2713-16
1200' oil
3/28 110 Nat 1000 acid
4/3 T.L. 2710 Oil 2713-16
T.D. 2716 1000 acid
213 Bbls.

COMPLETED

Map No. 13 Sec. 1 Twp. 25 R. 3E

Well No. 1C-McCracken
Vickers pt. Company _____

Contractor _____

FIRST REPORTS

SECTION PLAT

660 Ft. from N. Line

_____ Ft. from S. Line

_____ Ft. from E. Line

440 Ft. from W. Line

0			

Location _____

Rig up _____

Drilling and Remarks:

Machine

RECORD

Cased _____ in., _____ ft.

Sand _____

Gas _____

Oil _____

Total Depth _____

PRODUCTION

1st 24 hrs. Nat. _____

1st 24 hrs. after shot _____

Gas _____ Cu. Ft.

Dry Hole _____

Abandoned _____

Date

1-9-35 192

ORVAL MANNSCHRECK

Scout

Map No. 13 Sec. 1 Twp. 25 R. 3 EWell No. 10-McCrackenVickers pet. Company

Contractor

COMPLETED

SECTION PLAT

0			

660 Ft. from N. Line

Ft. from S. Line

Ft. from E. Line

440 Ft. from W. Line

RECORD

Location

Cased + in., ft.

Rig up

Sand TL 2710

Drilling and Remarks:

Gas

Oil 2713-16Total Depth 2716

PRODUCTION

1st 24 hrs. Nat.

1st 24 hrs. after shot

Gas Cu. Ft.

Dry Hole

Abandoned

Date

ORVAL MANNSCHRECK

4-3-35 192 Scout