


Map No. _____ Sec. 4 Twp. 25 R. 9

Well No. 8 Henley Farm _____
Ragers et al Company _____

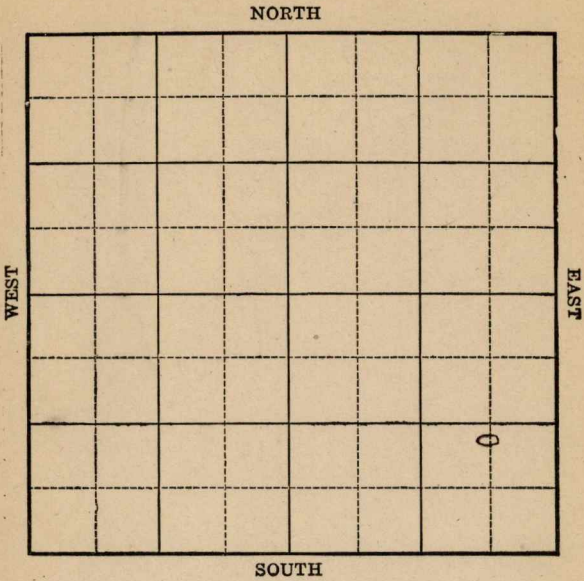

Location _____

Drilling Remarks:

RECORD

Cased _____ in. _____ ft.

Sand _____

Gas _____

Oil _____

Total Depth _____

Rig up _____

Drilling Remarks:

PRODUCTION

1st 24 hrs Nat. _____

1st 24 hrs. after shot _____

Gas _____ cu. ft.

Dry Hole _____


Abandoned _____

Map No. _____ Sec. 4 Twp. 25 R. 9Well No. 8 Henley Farm
Rogers etal Company

____ Ft. from N. Line

760 Ft. from S. Line660 Ft. from E. Line

____ Ft. from W. Line

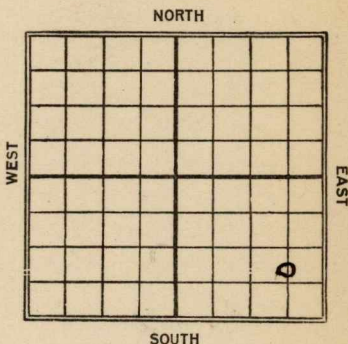

Date

REPORT

1923
3/22
6/10Location
abandoned location

KANSAS 15 4 Twp. 25 R. 9
 Map No. _____ Sec. _____ Twp. _____ R. _____
 Well No. *D Humphrey* _____
Lapores et al _____ Company
 _____ Contractor

FIRST REPORT

SECTION PLAT

_____ Ft. from N. Line
1120 _____ Ft. from S. Line
660 _____ Ft. from E. Line
 _____ Ft. from W. Line

			o

Location *V V* _____
 Rig up _____
 Drilling and Remarks: _____

RECORD

Cased _____ in., _____ ft.
 Sand _____
 Gas _____
 Oil _____
 Total Depth _____

PRODUCTION

1st 24 hrs. Nat. _____
 1st 24 hrs. after shot _____
 Gas _____ Cu. Ft.
 Dry Hole _____
 Abandoned _____

Date

MAR 22 1923

M. A. BENEAR

Scout

Have one # 8 on this
lead. Is this correct
number?

This should be # 8 I think

I had it located
one location south
of where it should
be. This is correct loc.

RECORD		Location	
Cased in	ft.	Rig up	
Sand		Drilling and Remarks:	
Gas			
Oil			
Total Depth			
PRODUCTION		Returned	
1st 24 hrs. Nat.		Cards	
1st 24 hrs. after shot		Tracing	
Gas		map C. S.	
Dry Hole		map	
Abandoned			
		Moody map	
		Moody plat book	
		Moody plat book	

Map No. **KANSAS** *15* Sec. *4* Twp. *25* R. *9*

Well No. *8 Henry*

Rogers & Bettler Company

Contractor

ABANDONED SECTION PLAT

-----Ft. from N. Line

1120 Ft. from S. Line

660 Ft. from E. Line

-----Ft. from W. Line

			<i>0</i>

Location -----

Rig up -----

Drilling and Remarks:

*Rig
abandoned*

RECORD

Cased ----- in., ----- ft.

Sand -----

Gas -----

Oil -----

Total Depth -----

PRODUCTION

1st 24 hrs. Nat. -----

1st 24 hrs. after shot -----

Gas ----- Cu. Ft.

Dry Hole -----

Abandoned -----

Date

JUN 10 1923

M. A. BENEAR

-----192----- Scout