

SECTION 4 TOWNSHIP Greenwood 25 RANGE 9 E **KANSAS**

WELL NO. #0-4D Henley

COMPANY Schie Pet.

NORTH

				0			

SOUTH

Greenwood

KANSAS

SEC.	TWP.	R.
4	25	9E

WELL NO.

#0-4D Henley

FARM

COMPANY

Sohio Petr.

CONTRACTOR

Berentz

Polhamus


Ft. from N. Line

Ft. from S. Line

Ft. from E. Line

Ft. from W. Line

SW SW SE

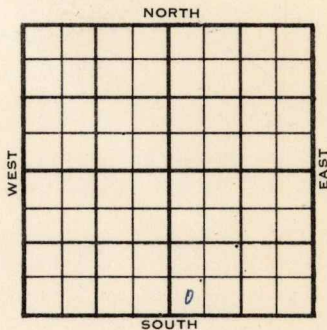

ELEVATION

REPORT

1956

1-18

Comm. 1-16-56

8" @ 60/60

WOC

TOPS	DEPTH	LOG	DATUM	Loc. in Sec. _____
Anh.				SW SW SE
TP.				
H.				
Tr.				
Dg.				
BL.				
L.				Geol. _____
K.C.				Contr. _____
B.K.C.				
Ce.				Berontz
C.				
M.				Pool _____
M.				
K.				Polhamus
Mz.				
Me.				JAN 18 1936 FIRST REPORT 0
V.				
S.				
S.				
A.				
R.				
Pe.				
G.				
TD.				

Date Comm. 1-16-56
8" @ 60/60 WOC


County **Greenwood** Elev. **1172 KD**
 Sec. **14** Twp. **25** Rge. **9E**
 Company **Schic Pet.**
 Farm Name **Benley** No. **0-4D**

TOPS	DEPTH	LOG	DATUM	Loc. in Sec.
Ant.				SW SW SE
TP				
H. <i>Barth 20</i>		<i>2111</i>	<i>939</i>	
Tc. <i>157 sd</i>		<i>2117-28</i>		
Dg.		<i>2198-2218</i>		
Bl.				
L.				Geol.
N.C.				Cont.
B.K.C.				Berentz
Co.				Pool
C.				Polhamus
M.				
M.				
K.				
Ma.				
Ma.				
V.				
S.				
S.				
A.				
R.				
PC.				
Q.				
20	2218			

COMPLETE

Date Comm. **1-16-56**

FEB 29 1956

8" @ 60/60 WOC JAN 25 '56 CRD 2121-46

see 25' crg ahead FEB 1 '56 CRD

2146-2219 see 73' 5 1/2 2218

FEB 8 '56 Co 9/2199-2202 n. Fluid

16/2192-97 @ 2 GW in 1 hr Frac

Lost 6d P.B 2125 48/2128-36

n. Fluid 24/2120-24 @ 1 1/2 GW

(summit) Frac FEB 15 '56 & LD FEB 22 '56

& LD. FEB 29 '56 P. 12.86 BO +

24.52 BW 24 hrs

R. G.

MAR 9 1956