



Sec. 1 Twp. 25 R. 3-E


Well No. #3 McCraner "C" Farm  
Vickers Petr. Company

500 Ft. from N. Line

\_\_\_\_\_ Ft. from S. Line

\_\_\_\_\_ Ft. from E. Line

700 Ft. from W. Line

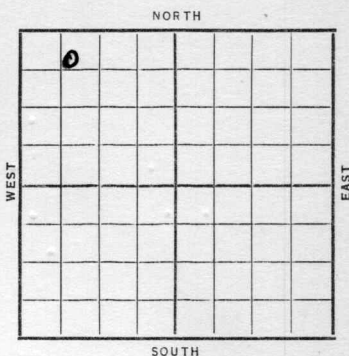

Date	REPORT
1938	
2/2	Mach.
2/11	R. U.
2/18	15" @ 54'. Drlg. 445'.
2/26	Drlg. 760'.
3/4	12" @ 1110'. 10" @ 1600'.
	Drlg. 1615'.
3/11	Drlg. 1820'.
3/18	8" @ 2131'. Drlg. 2540'.
3/25	K.C. 2265'. T.D. 2559'.
	No shows. Rng. 7".
4/1	7" @ 2616'. Miss. 2706'.
	Rng. 5".
4/8	5" @ 2706'. Drlg. 2710'.
	OVER

1938

4/13

5" @ 2707'.

Miss. 2706'.

T.D. 2728'.

2000 acid.

Potential 47 bbls.,

COMPLETED

Butler KANSAS

Map No. 13 Sec. 1 Twp. 25 R. 3E

Well No. 3 McCraner "C"

Vickers Petroleum Company

Contractor

FIRST REPORT

SECTION PLAT

NE NW NW

500 Ft. from N. Line

\_\_\_\_\_ Ft. from S. Line

\_\_\_\_\_ Ft. from E. Line

700 Ft. from W. Line

0			

Location \_\_\_\_\_

Rig up \_\_\_\_\_

Drilling and Remarks:  
Mach.

RECORD

Cased \_\_\_\_\_ in., \_\_\_\_\_ ft.

Sand \_\_\_\_\_

Gas \_\_\_\_\_

Oil \_\_\_\_\_

Total Depth \_\_\_\_\_

PRODUCTION

1st 24 hrs. Nat. \_\_\_\_\_

1st 24 hrs. after shot \_\_\_\_\_

Gas \_\_\_\_\_ Cu. Ft.

Dry Hole \_\_\_\_\_

Abandoned \_\_\_\_\_

Date

H. D. Hatfield

FEB 2 1938 19 \_\_\_\_\_ Scout

Map No. 13 Sec. 1 Twp. 25 R. 3E

Well No. 3 McCraner "C"

Vickers Petroleum Company

Contractor

COMPLETED

SECTION PLAT

NE NW NW

500 Ft. from N. Line

\_\_\_\_\_ Ft. from S. Line

\_\_\_\_\_ Ft. from E. Line

700 Ft. from W. Line

0			

Location \_\_\_\_\_

Rig up \_\_\_\_\_

Drilling and Remarks:

*good acid*

*Pot 47*

RECORD

Cased 7 in., 2707 ft.

Sand MISS 2706

Gas \_\_\_\_\_

Oil \_\_\_\_\_

Total Depth 2728

PRODUCTION

1st 24 hrs. Nat. \_\_\_\_\_

1st 24 hrs. after shot \_\_\_\_\_

Gas \_\_\_\_\_ Cu. Ft.

Dry Hole \_\_\_\_\_

Abandoned \_\_\_\_\_

Date

APR 13 1938

H. D. Hatfield Scout