


Butler

Section 1 Township 25 Range 3EWell No. #1 O. E. MooreCompany R. J. Wixson

NORTH

WEST

EAST

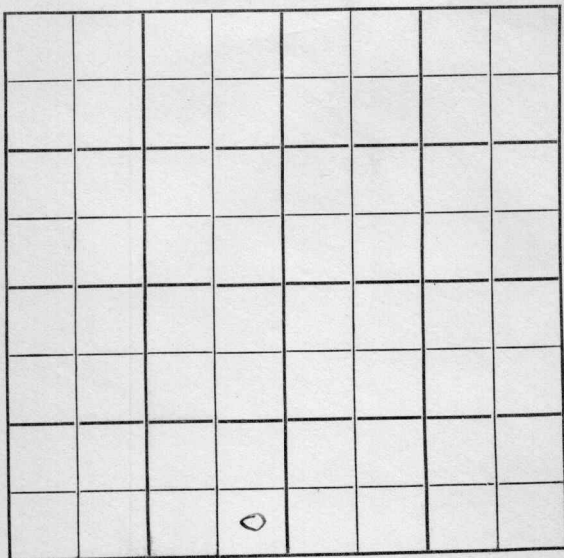

SOUTH

Butler KANSAS
25 3E

Sec. 1 Twp. R. ✓

Well No. #1 O. E. Moore Farm

R. J. Wixson Company

Contractor

Miscellaneous


Ft. from N. Line

330' Ft. from S. Line

330' Ft. from E. Line

Ft. from W. Line

SE SE SW

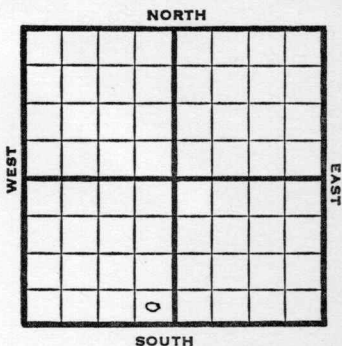

1950

Elev 1300'

REPORT

2/22 MIM

4/5 TD 2684'

12" @ 69'

Chat 2661'

5" @ 2663'

6 BOPD

Comp

COMPLETED

Map No. _____ Sec. 1 Twp. 25 R. 3EWell No. 1 O.E. MooreR. J. Wixson Company

Contractor

SE SE SW

SECTION PLAT

_____ Ft. from N. Line

330 Ft. from S. Line330 Ft. from E. Line

_____ Ft. from W. Line

FIRST REPORT

0

Butler County

Location _____

Rig up _____

Drilling and Remarks:

M I M

RECORD

Cased _____ in., _____ ft.

Sand _____

Gas _____

Oil _____

Total Depth _____

PRODUCTION

1st 24 hrs. Nat. _____

1st 24 hrs. after shot _____

Gas _____ Cu. Ft.

Dry Hole _____

Abandoned _____

Date


J. E. TYRA

FEB 22 1950 19

Scout

Map No. _____ Sec. 1 Twp. 25 R. 3EWell No. 1 O.E. Moore_____
R. J. Wixson Company_____
Contractor

SE SE SW

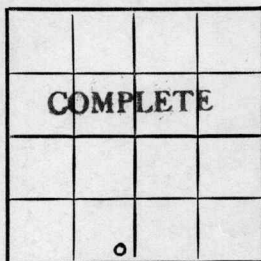E/ 1300
SECTION PLAT_____
Ft. from N. Line330 Ft. from S. Line330 Ft. from E. Line_____
Ft. from W. Line

Butler County

Location _____

Rig up _____

Drilling and Remarks:

12" @ 69'Chat 26615" @ 26636 BOPD

RECORD

Cased _____ in., _____ ft.

Sand _____

Gas _____

Oil _____

Total Depth 2684

PRODUCTION

1st 24 hrs. Nat. _____

1st 24 hrs. after shot _____

Gas _____ Cu. Ft.

Dry Hole _____

Abandoned _____

Date

APR 5

1950

19

J. E. TYRA

Scout