


Map No. 7 Sec. 5 Twp. 25 R. 9
 Well No. 1 Cartwright Farm
Basin Ethel Company.

NORTH

WEST

EAST

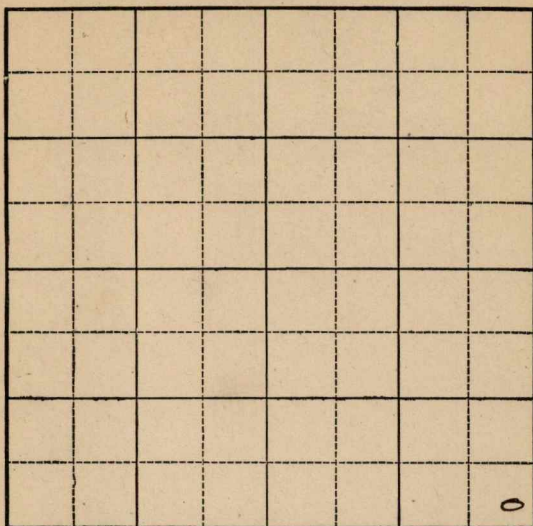

SOUTH

Location _____

Rig up _____

Drilling Remarks:

Drilling Remarks:

RECORD

Cased _____ in. _____ ft.

Sand _____

Gas _____

Oil _____

Total Depth _____

PRODUCTION

1st 24 hrs Nat. _____

1st 24 hrs. after shot _____

Gas _____ cu. ft.

Dry Hole _____


Abandoned _____

Map No. X Sec. 5 Twp. 25 R. 9Well No. 1 Barrington Farm
Bosman & Hul Company

Ft. from N. Line

200 Ft. from S. Line200 Ft. from E. Line

Ft. from W. Line

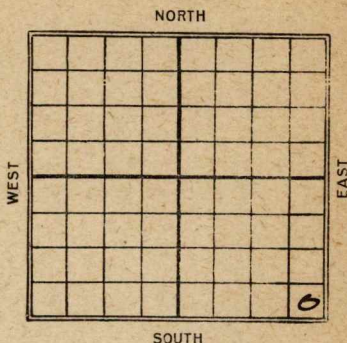

REPORT

1924
 6/15 Rig up
 7/16
 10/28 Tap. L. 2272 -
 L.O. & G. 2505'
 11/26 S.D. 2560'
 12/17 Tap. second break 2610-20
 Rig burned.
 1925
 1/21 Sho 2345-52 S.D.
 T.D. 2751
 3/30 T.D. 2252 Wilcox 2610-20
 Show 2345-52
 Abandoned 2751

15 **KANSAS** Sec. 5 Twp. 25 R. 9
Map No. _____
Well No. 1 *Carington*
Bosum Company

Contractor _____

FIRST REPORT

SECTION PLAT

_____ Ft. from N. Line
200 _____ Ft. from S. Line
200 _____ Ft. from E. Line
_____ Ft. from W. Line

			0

Location _____
Rig up *✓✓* _____
Drilling and Remarks: _____

RECORD

Cased _____ in., _____ ft.
Sand _____
Gas _____
Oil _____
Total Depth _____

PRODUCTION

1st 24 hrs. Nat. _____
1st 24 hrs. after shot _____
Gas _____ Cu. Ft.
Dry Hole _____
Abandoned _____

Date JUN 18 1924
_____ 192 _____ Scout

Map No. **KANSAS** Sec. **5** Twp. **25** R. **9**

Well No. **1 Carrington**
Basum et al. Company

Contractor

ABANDONED SECTION PLAT

_____ Ft. from N. Line

200' _____ Ft. from S. Line

200' _____ Ft. from E. Line

_____ Ft. from W. Line

			0

Location _____

Rig up _____

Drilling and Remarks:

Tap 1. 2252'

Wilcox 2610-20

show 2345-52

RECORD

Cased _____ in., _____ ft.

Sand _____

Gas _____

Oil _____

Total Depth _____

PRODUCTION

1st 24 hrs. Nat. _____

1st 24 hrs. after shot _____

Gas _____ Cu. Ft.

Dry Hole **✓** _____

Abandoned **2751'** _____

Date

3/30 192 **5**

M. A. BENEAR

Scout