


Section 6 Township 25 Range 9 E

Well No. # 6 Carrington

Company Franco-Central

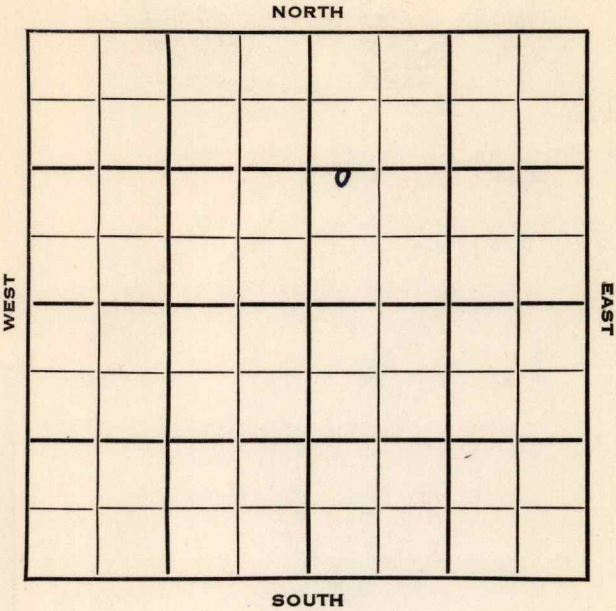

Greenwood

KANSAS ✓

Sec. 6 Twp. 25 R. 9EWell No. #6 Carrington FarmFranco-Central


Company

White & Ellis

Contractor

 Ft. from N. Line1260 Ft. from S. Line Ft. from E. Line300 Ft. from W. Line

NW SW NE

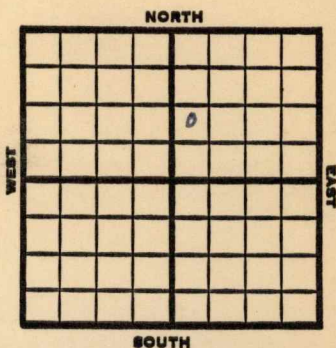

1953

Elev. -

REPORT

8/5

Spud 7-23-53

8" @ 150'

KC 1812'

TD 2230'

5½" @ 2215'

DD 2233

Hydrofrac

Swb.

8/12

Spud 7-23-53

Oil Well

TD 2233

8" @ 150

KC 1812

TD 2230

5" @ 2215

DD 2233, Hydro

Cattleman sd 2215

Comp. 20 bopd 4 bw

COMPLETED

Kansas

6

Franco-Central

6

Location

0

FIRST REPORT

52

W

AUG

Remarks

White & Ellis - Contr.

Spudding Date 7-23-53

Drlg. Data

8" @ 150 KC 1812 TD 2230 5½" @ 2215

DD 2233 Hydrofrac Swb.

J. G. McGEHEE

J. G. McGEHEE