


Section 30 Township 25 Range 8E

Well No. #1 Jahren

Company H. M. Williams

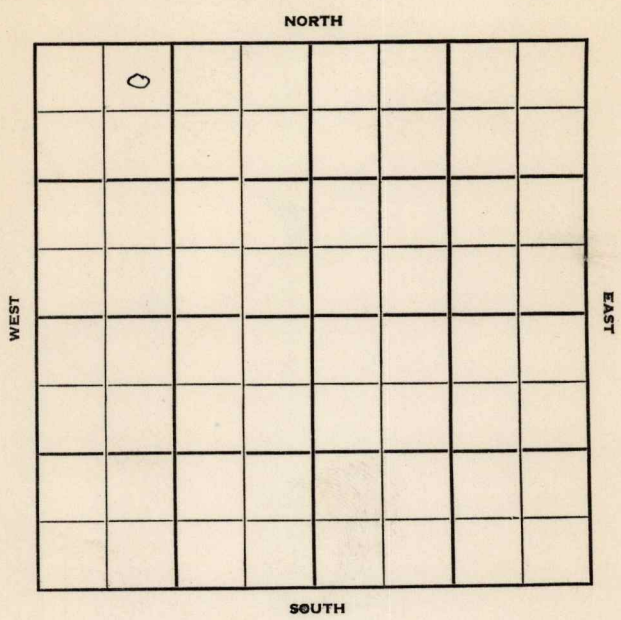

Butler

KANSAS

Sec. 30 Twp. 25 R. 8E

Well No. #1 Jahren Farm

H. M. Williams Company

Uhl - Contr. Contractor
Wildcat


330' Ft. from N. Line

 Ft. from S. Line

 Ft. from E. Line

990' Ft. from W. Line

NE Cor of Lot 2

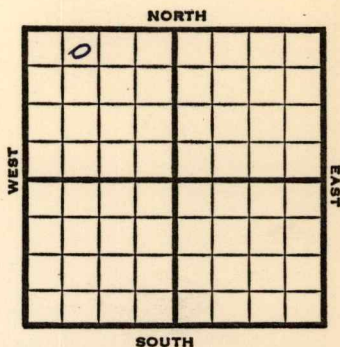

1951 Elev. - REPORT

9/26 Location

10/31 Spud 10-19-51

D&A TD 2788

8" @ 81'

Bart Sand 2747 Miss 2767

TD 2788 D&A

ABANDONED

County **Butler** State **Kansas**
 Sec. **30** (Blk. Twp.) **25** (Sur. Rge.) **8E** Map No.
 Operator **H. M. Williams**
 Well No. **1** Farm **Jahren**
 Elev. Location **NE Corner of Lot 2**

0					

330 Ft. From **N** Line **NE**
990 Ft. From **W** Line **Quarter**
 Ist. Report **SEP 26 1951**

Completion

Remarks

Uhl - Contr.

Spudding Date

Drlg. Data **Wildcat**

Location

J. E. TYRA

County Butler State Kansas
 Sec. 30 (Blk. 25) (Sur. 8E) Map No. _____
 Operator H. M. Williams
 Well No. 1 Farm Jahren
 Elev. _____ Location NE Corner of Lot 2

0							

330 Ft. From N Line NE

990 Ft. From W Line Quarter

1st. Report

Completion OCT 31 1951

Remarks

Uhl Drlg. - Contr.

Spudding Date 10-19-51

Drlg. Data D & A TD 2788

8" @ 81 Bart. sand 2747 Miss. 2767

TD 2788 D & A

J. E. TYRA