


Butler

Map No. KANSAS Sec. 1 Twp. 25 R. 3E

Well No. 1 Wilson Est. Farm
Sheldon & Wilson Company

330 Ft. from N. Line
____ Ft. from S. Line
____ Ft. from E. Line
990 Ft. from W. Line

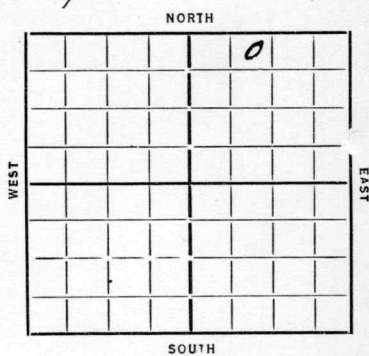

Date 1935 REPORT

2/6 Ponds
2/14 Moving in
2/21 Rgn
2/28 Dlg 440 15 1/2 46
3/7 " 1200
3/14 " 1647
3/21 " 1693
3/28 " 2515
4/4 TL 2657 SO 2670 T) 2681
6" 2670
4/11 Pay 2673-90 2711 SW
PB 2690 1000 acid
4/17 Time 2659 T) 2711
PB 2690 1000 acid
182 Bbls.

COMPLETED

Map No. 13 Sec. 1 Twp. 25 R. 3E

Well No. 1- Wilson Est

Sheldon + Wipon Company

Contractor

FIRST REPORTS

SECTION PLAT

330 Ft. from N. Line

..... Ft. from S. Line

..... Ft. from E. Line

990 Ft. from W. Line

		0	

Location.....

Rig up.....

Drilling and Remarks:

ponds

RECORD

Cased..... in., ft.

Sand.....

Gas.....

Oil.....

Total Depth.....

PRODUCTION

1st 24 hrs. Nat.....

1st 24 hrs. after shot.....

Gas..... Cu. Ft.

Dry Hole.....

Abandoned.....

Date

2-6-35 192.....

ORVAL MANNSCHRECK

Scout

Map No. 13 Sec. 1 Twp. 25 R. 3E

Well No. 1-G. H. Wilson est
Sheldon + Wilson Company

Contractor

COMPLETED

SECTION PLAT

330 Ft. from N. Line
..... Ft. from S. Line
..... Ft. from E. Line
990 Ft. from W. Line

		0	

Location.....

Rig up.....

Drilling and Remarks:

JB 2690
1000 and
182 bbls

RECORD

Cased..... in., ft.
Sand Line 2659
Gas.....
Oil.....
Total Depth 2711

PRODUCTION

1st 24 hrs. Nat.....
1st 24 hrs. after shot.....
Gas..... Cu. Ft.
Dry Hole.....
Abandoned.....

Date

4-17-35 192

ORVAL MANNSCHRECK

Scout