
FORM 51 25M 3-49 PETROL

KANSAS Butler

Section 1 Township 25 Range 3-E

Well No. #2 O E Moore "B"

Company R J Wixson

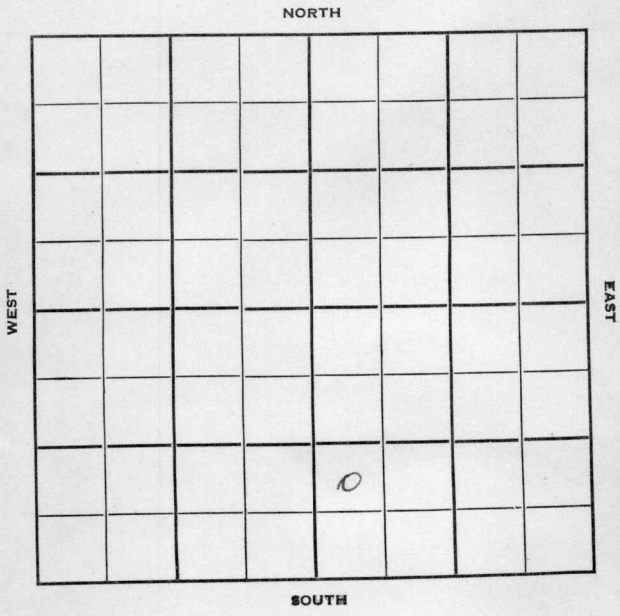

FORM 252-B
10M 9-49 PETROL

Butler KANSAS

Sec. 1 Twp. 25 R. 3E

Well No. #2 O. E. Moore "B" Farm

R. J. Wixson Company

Contractor

Miscellaneous


Ft. from N. Line

990' Ft. from S. Line

Ft. from E. Line

330' Ft. from W. Line

NW SW SE

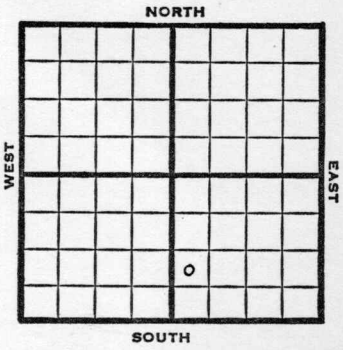

1950	REPORT
	Elev 1301
4/5	13" @ 75' Drlg. 120'
5/10	TD 2675 13" @ 75 10" @ 1448 Lans 1953 8" @ 2352 7" @ 2477 Miss 2661 5" @ 2662 30 BOPD Completed COMPLETED

Form 26 200 Bks. 11-49 Petrol

Kansas

Miscellaneous

Map No. _____ Sec. 1 Twp. 25 R. 3E


Well No. 2 O. E. Moore "B"

R. J. Wixson
Company

Contractor

NW SWSE

SECTION PLAT

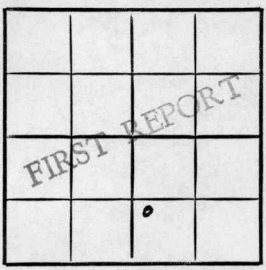

_____ Ft. from N. Line

990 Ft. from S. Line

_____ Ft. from E. Line

330 Ft. from W. Line

Butler County

Location _____

Rig up _____

Drilling and Remarks:

13" @ 75

drlg. 120

RECORD

Cased _____ in., _____ ft.

Sand _____

Gas _____

Oil _____

Total Depth _____

PRODUCTION

1st 24 hrs. Nat. _____

1st 24 hrs. after shot _____

Gas _____ Cu. Ft.

Dry Hole _____

Abandoned _____

Date

APR 5 1950 19

J. E. TYRA
Scout

Form 26 200 Bks. 11-49 Petrol Miscellaneous

Kansas

Map No. _____ Sec. 1 Twp. 25 R. 3E

Well No. 2 O. E. Moore "B"


R. J. Wixson Company

Contractor

NW SW SE

El. 1301

SECTION PLAT

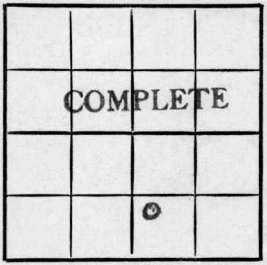

_____ Ft. from N. Line

990 Ft. from S. Line

_____ Ft. from E. Line

330 Ft. from W. Line

Butler

Location _____

Rig up _____

Drilling and Remarks:

13" @ 75'
10" @ 1448
Lans 1953
8" @ 2352
7" @ 2477
Miss 2661
5" @ 2662

30 BOPD

RECORD

Cased _____ in., _____ ft.

Sand _____

Gas _____

Oil ✓

Total Depth 2675'

PRODUCTION

1st 24 hrs. Nat. _____

1st 24 hrs. after shot _____

Gas _____ Cu. Ft.

Dry Hole _____

Abandoned _____

Date

MAY 10 1950

19

J. E. TYRA

Scout