KANSAS

Pawnee


FORM 51 5M 4-41 PETROL

Section 24 Township 20 Range 16-W

Well No. #1 Bixby

Company Derby

Pawnee Rock

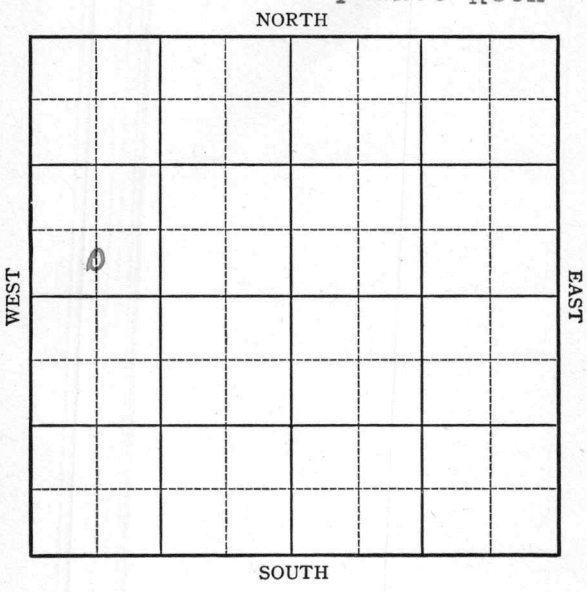

FORM 252-A 5M 6-41 PETROL KANSAS Pawnee

Sec. 24 Twp. 20 R. 16-W

Well No. #1 Bixby Farm

Derby Company


(Pawnee Rock)

[illegible] Ft. from N. Line

330 Ft. from S. Line

_____ Ft. from E. Line

660 Ft. from W. Line

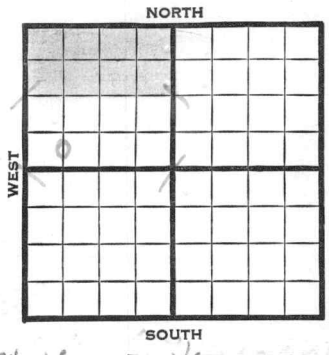

18' H ... now plug ...

1941	REPORT Elev. 2066
10/1	Location
10/14	Surface hole (Tel)
10/16	8" - 731' Drlg. 2373'
10/23	Lans. 3490' Drlg. 3600'
10/29	Top Arbuckle 3788
	Good saturation in cuttings 3788-3803
	TD 3803 4" 3803 (Tel)
11/6	12 shots 3798-3801'
	56 shots 3801-3790' 500 acid.
	Trace oil. Drilled deeper.
	Pay 3805-06' T.D. 1000' oil 7
	hours.
11/13	500 acid. Swab 1 bbls. oil per
	hour. T.D. 3817'
	Water 3815-17' P.B. to 3812'
	1000 acid. Swab 1¼ oil per hour
	for 5 hours, 2% water.
	Shut down.

OVER

1941
11/19 Arb. 3788'
4" - 3803'
T.D. 3817'
P.B. to 3812'
1000 acid.
Swab 62 bbls. plus 10% water.
38. Gravity

COMPLETED

Form 26 200 Bks. 5-41 McW. Pawnee KANSAS

Map No. K-81 Sec. 24 Twp. 20 R. 16W

Well No. 1 Bixby

Derby Company

FIRST REPORT Contractor

C SL SW NW


____ Ft. from N. Line

330 Ft. from S. Line

____ Ft. from E. Line

660 Ft. from W. Line

SECTION PLAT

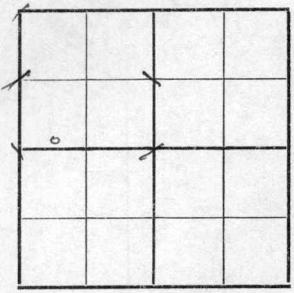

PAWNEE ROCK

Location ✓

Rig up

Drilling and Remarks:

Reported 330' from N. Line

RECORD

Cased ____ in., ____ ft.

Sand

Gas

Oil

Total Depth

PRODUCTION

1st 24 hrs. Nat.

1st 24 hrs. after shot

Gas ____ Cu. Ft.

Dry Hole

Abandoned

Date

OCT 11 1941 19 S. J. LEWIS Scout

Form 26 200 Bks. 5-41 McW. Pawnee KANSAS

Map No. IT-81 Sec. 24 Twp. 20 R. 16W

Well No. 1 Bixby

Derby Company

COMPLETED Contractor

C SL SW NW


Ft. from N. Line

330 Ft. from S. Line

Ft. from E. Line

660 Ft. from W. Line

SECTION PLAT

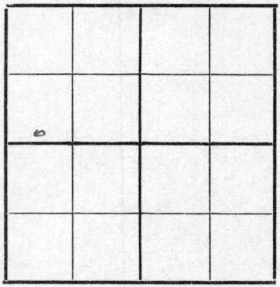

PAWNEE ROCK POOL

Location

Rig up

Drilling and Remarks:

Cir ¥ 3788
4" @ 3803
PB 3812.
1000 acid
Sw ¥ 62 Pump + 1/2
Water
380 Gr

RECORD

Cased in., ft.

Sand

Gas

Oil

Total Depth 3812

PRODUCTION

1st 24 hrs. Nat.

1st 24 hrs. after shot

Gas , Cu. Ft.

Dry Hole ,

Abandoned

Date

NOV 1 9 1941 19 S. J. LEWIS Scout