
FORM 51 10M 8-47

KANSAS Pawnee

Section 24 Township 20 Range 16W

Well No. #1 Bixby "B"

Company W. P. Faulkner etal.

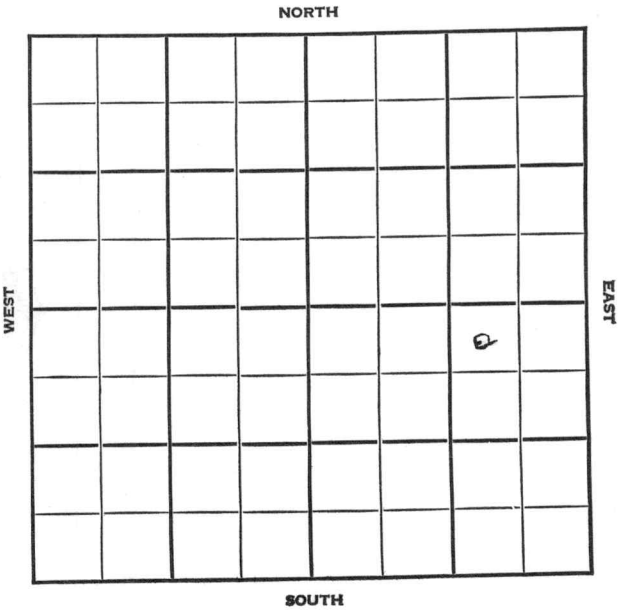

FORM 252-A
5M 9-47 PETROL

KANSAS Pawnee

Sec. 24 Twp. 20 R. 16W

Well No. #1 Bixby "B" Farm

W. P. Faulkner et al Company

Pawnee Rock


330 Ft. from N. Line

Ft. from S. Line

990 Ft. from E. Line

Ft. from W. Line

NW NE SE

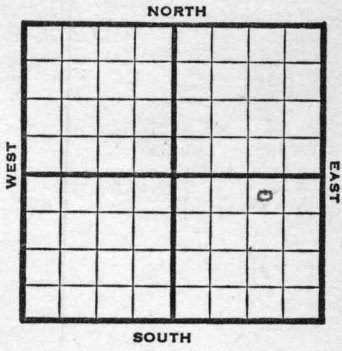

1948	REPORT
	Elev. 2062'
1/21	Drlg. 810'
1/26	8" @ 1023' Drlg 2310'
2/4	Drlg. 3300'
2/11	Lansing 3476' BKC 3718' Arbuckle 3776-92' TD 5" @ 3789' RUST
2/18	"
2/25	"
3/3	"
3/10	"
3/17	"
3/24	"
3/31	"
4/7	"
4/14	"
4/21	"
4/28	"
5/5	"
5/12	"

OVER

1948

5/19 Lansing 3476'
BKC 3718'
Arbuckle 3776-92' TD
5" @ 3789'
RUST

5/26 TD 3792'

6/1 "

6/9 "

6/16 "

6/23 "

6/30 Arbuckle 3776'
5" @ 3789'
Acid 1000
Pump 40 oil Pot.
Gr. 38°
TD 3816'
COMPLETED

Form 26 200 Bks. 10-46 Petrol

Kansas

Pawnee Rock Pool

Map No. _____ Sec. 24 Twp. 20 R. 16W

Well No. 1 Bixby "B"

W. P. Faulkner etal. Company

FIRST REPORT Contractor

NW NE SE

330 Ft. from N. Line


_____ Ft. from S. Line

990 Ft. from E. Line

_____ Ft. from W. Line

Pawnee County

SECTION PLAT

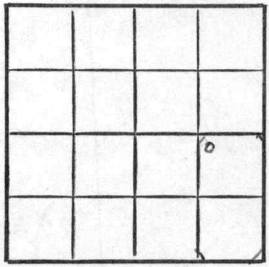

Location _____

Rig up _____

Drilling and Remarks:

drlg. 810

RECORD

Cased _____ in., _____ ft.

Sand _____

Gas _____

Oil _____

Total Depth _____

PRODUCTION

1st 24 hrs. Nat. _____

1st 24 hrs. after shot _____

Gas _____ Cu. Ft.

Dry Hole _____

Abandoned _____

Date

JAN 21 1948 19 S. J. LEWIS Scout

Form 26—200 Bks.—1-48—Palace

Pawnee Rock

Kansas

Map No. 81 Sec. 24 Twp. 20 R. 16W

Well No. 1 Bixby "B"


W. P. Faulkner etal. Company

COMPLETE Contractor

NW NE SE

Elev. 2062

SECTION PLAT

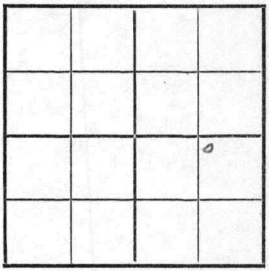

330 Ft. from N. Line

Ft. from S. Line

990 Ft. from E. Line

Ft. from W. Line

Pawnee County

Location

Rig up

Drilling and Remarks:

Ran 3776

5" @ 3788

1000 acid

Pmpg. 40 oil Bbls

38° Gr

RECORD

Cased in., ft.

Sand

Gas

Oil ✓

Total Depth 3876

PRODUCTION

1st 24 hrs. Nat.

1st 24 hrs. after shot

Gas Cu. Ft.

Dry Hole

Abandoned

Date

JUN 30 1948 19

S. J. LEWIS Scout