


Section 2- Township 25 Range 3-E

Well No. #1 Lang

Company Adair & Morton

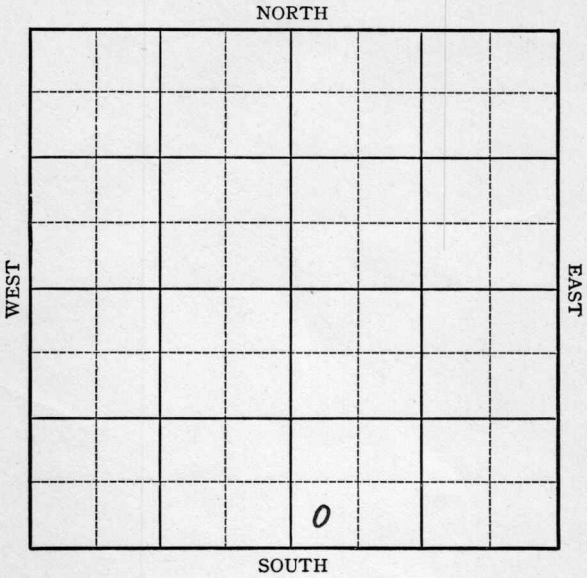

Sec. 2 Twp. 25 R. 3-E

Well No. #1 Lang Farm

Adair & Morton Company

(Eldorado)


_____ Ft. from N. Line

330 Ft. from S. Line

_____ Ft. from E. Line

330 Ft. from W. Line

Elev. 1344

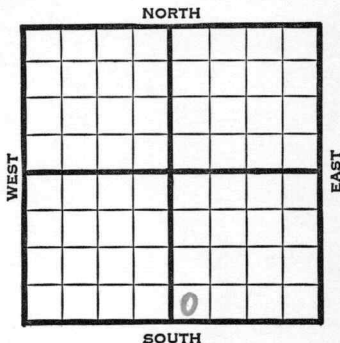

1941	REPORT
6/4	Location
6/12	"
6/19	"
6/26	"
7/3	"
7/10	"
7/17	"
7/24	Machine
7/31	12" @ 1145' 15" @ 59' Drlg. 1170
8/7	10" @ 1640' Drlg. 2050'
8/15	Lansing 2010 K.C. 2282 Base K.C. 2404 8" 2410 Miss 2714-15$\frac{1}{2}$ Dlg. 2745 in Congl.
8/20	Miss. 2714'
	6" - 2745'
	T.D. 2815'
	No shows.
	ABANDONED

Map No. 13 Sec. 2 Twp. 25 R. 3E

Well No. 1 Lang

Adair & Morton Company

Contractor

FIRST REPORT

SW SE

SECTION PLAT

		o	

Ft. from N. Line

330 Ft. from S. Line

Ft. from E. Line

330 Ft. from W. Line

ELDORADO POOL

Location X

Rig up _____

Drilling and Remarks:

RECORD

Cased _____ in., _____ ft.

Sand _____

Gas _____

Oil _____

Total Depth _____

PRODUCTION

1st 24 hrs. Nat. _____

1st 24 hrs. after shot _____

Gas _____ Cu. Ft.

Dry Hole _____

Abandoned _____

Date

JUN 4 1941 19

S. J. LEWIS Scout

Map No. 13 Sec. 2 Twp. 25 R. 3E

Well No. 1 Lang

Adair & Morton Company

ABANDONED Contractor

SECTION PLAT

SW SE
_____ Ft. from N. Line
330 Ft. from S. Line
_____ Ft. from E. Line
330 Ft. from W. Line

ELDORADO POOL

Location _____

Rig up _____

Drilling and Remarks:

Wise 2714
6" @ 2745
No show

RECORD

Cased _____ in., _____ ft.
Sand _____
Gas _____
Oil _____
Total Depth 2815

PRODUCTION

1st 24 hrs. Nat. _____
1st 24 hrs. after shot _____
Gas _____ Cu. Ft.
Dry Hole _____
Abandoned _____

Date

AUG 20 1941 19

S. J. LEWIS Scout