


Butler KANSAS

Section 2 Township 25 Range 3E

Well No. #1 Mulnix

Company Crest Pet. et al

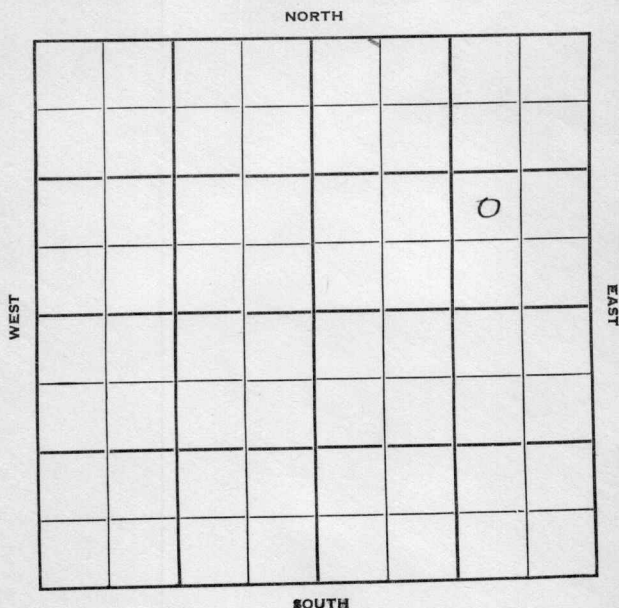

Butler

KANSAS

Sec. 2 Twp. 25 R. 3E ✓

Well No. #1 Mulnix Farm

Crest Pet. et al Company

Contractor

Miscellaneous


Ft. from N. Line

990' Ft. from S. Line

990' Ft. from E. Line

Ft. from W. Line

NW SE NE

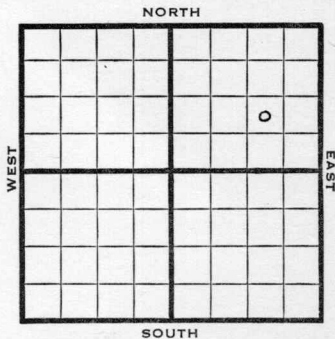

1950

Elev 1343

REPORT

4/19

Spud 4-15-50
8-5/8" @ 103'
Drlg. 1142'

5/17

8 5/8" 103
Miss 2718
5" @ 2718
TD 2722
50 BOPD
Completed

COMPLETED


Map No. _____ Sec. 2 Twp. 25 R. 3EWell No. 1 Mulnix

_____ Crest Pet. etal. _____ Company

_____ Contractor

NW SE NE

SECTION PLAT

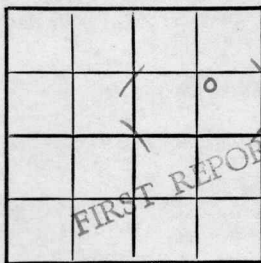

_____ Ft. from N. Line

990 Ft. from S. Line990 Ft. from E. Line

_____ Ft. from W. Line

Butler County

Location _____

Rig up _____

Drilling and Remarks:

Spud 4-15-50

8 5/8" @ 103

drlg. 1142

RECORD

Cased _____ in., _____ ft.

Sand _____

Gas _____

Oil _____

Total Depth _____

PRODUCTION

1st 24 hrs. Nat. _____

1st 24 hrs. after shot _____

Gas _____ Cu. Ft.

Dry Hole _____

Abandoned _____

Date

APR 19 1950 19

J. E. TYRA

Scout

Map No. _____ Sec. 2 Twp. 25 R. 3E

Well No. 1 Mulnix

Crest Pet. etal. Company

Contractor

NW SE NE


E1. 1343
SECTION PLAT

_____ Ft. from N. Line

990 Ft. from S. Line

990 Ft. from E. Line

_____ Ft. from W. Line

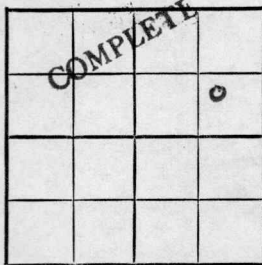

Butler

Location _____

Rig up _____

Drilling and Remarks:

8 5/8' @ 103
Miss 2718
5" @ 2718
T.D. 2722
50 BOPD

RECORD

Cased _____ in., _____ ft.

Sand _____

Gas _____

Oil _____

Total Depth _____

PRODUCTION

1st 24 hrs. Nat. _____

1st 24 hrs. after shot _____

Gas _____ Cu. Ft.

Dry Hole _____

Abandoned _____

Date

MAY 17 1950

19

J. E. TYRA

Scout