
FORM 51 25M 3-49 PETROL KANSAS Butler

Section 2 Township 25 Range 3-E

Well No. #2 Mulnix

Company Crest Pet.

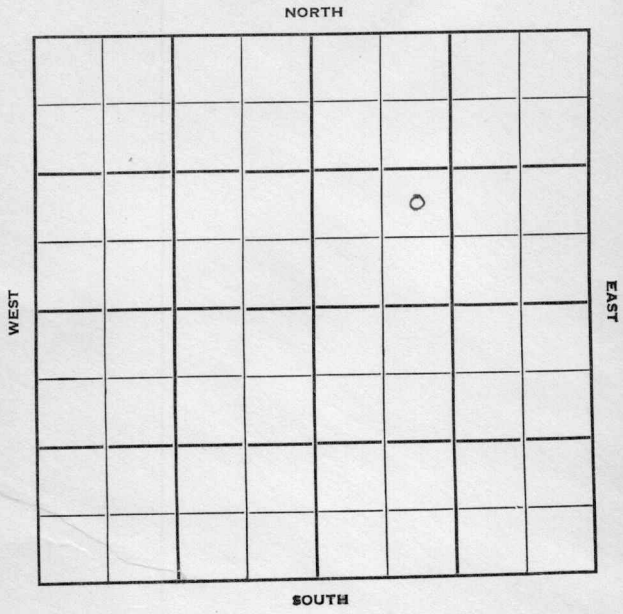

FORM 252-B
10M 9-49 PETROL

Butler

KANSAS

Sec. 2 Twp. 25 R. 3E

Well No. #2 Mulnix Farm

Crost Petroleum Company

Contractor

Miscellaneous


Ft. from N. Line

990' Ft. from S. Line

Ft. from E. Line

990' Ft. from W. Line

NE SW NE

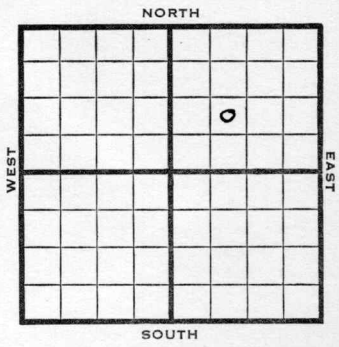

1950	Elev. 1329' REPORT
8/9	Spud 8-4-50 8-5/8" @ 101' Drlg. 2150'
9/13	Spud 8-4-50 Oil Well TD 2721' 8-5/8" @ 101' KC 2721' 500 A FU 850' fluid 50% wtr S/18 BO 20 BWPD Comp. 20 BOPD 20 BW

COMPLETED

FORM 275 FOR SALE BY KANSAS BLUE PRINT CO.


County Butler State Kansas

Sec. 2 (Blk. Twp.) 25 (Sur. Rge.) 3E Map No.

Operator Crest Petroleum

Well No. 2 Farm Mulnix

Elev. Location NE SW NE

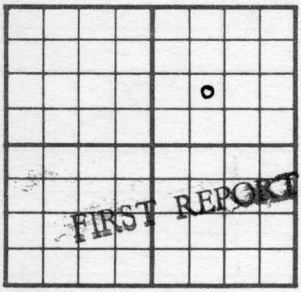

990 Ft. From S Line BE

990 Ft. From W Line Quarter

1st. Report AUG 9 1950

Completion

Remarks

Spudding Date 8-4-50

Drlg. Data

8 5/8" @ 101 drlg. 2150

J. E. TYRA

FORM 275 FOR SALE BY KANSAS BLUE PRINT CO.

County Butler State Kansas

Sec. 2 (Blk. Twp.) 2 5 (Sur. Rge.) 3E Map No.

Operator Crest Petroleum

Well No. 2 Farm Mulnix

Elev. 1329 Location NE SW NE



990 Ft. From S Line NE

990 Ft. From W Line Quarter

1st. Report

Completion SEP 1 3 1950

Remarks

Miscellaneous

Spudding Date 8-4-50

Drlg. Data Oil well TD 2721

8 5/8" @ 101 KC 2286 Miss. 2718-21

5½" @ 2718 TD 2721 500 A FU 850' fluid

50% water S/ 18 bo 20 bwpd

Comp. 20 bopd 20 bw

J. E. TYRA