


KANSAS

Section 24 Township 20 Range 16WWell No. #2 Deckert "C"Company Stanolind & Amerada

NORTH

WEST

EAST

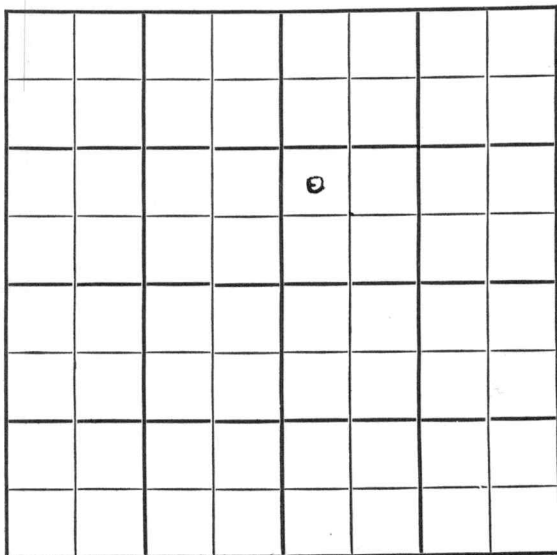

SOUTH

Sec. 24 Twp. 20 R. 16W

Well No. #2 Deckert "C" Farm

Stanolind & Amerada

Company

Pawnee Rock Pool


Ft. from N. Line

990' Ft. from S. Line

Ft. from E. Line

330' Ft. from W. Line

NW SW NE

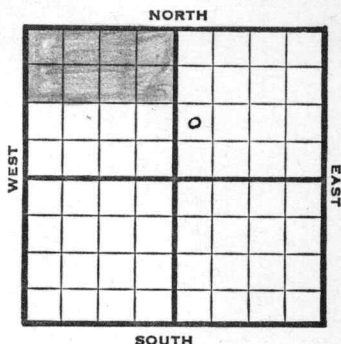

1948 Elev. 2112' REPORT

2/4 Anhy. 1114'
8" @ 1118'
WOC

2/11 Drlg. 3631'
2/18 Lansing 3520'
Simpson 3795'
Arbuckle 3800-45'
TD 3845'
5" @ 3843½'
RUST

2/25 "

3/3 Flow in pits
No gauge

3/10 "

3/17 "

3/24 "

3/31 Arbuckle 3800'
5" @ 3843½'
Flow 500
Gr. 390
TD 3845'

COMPLETED

Map No. _____ Sec. 24 Twp. 20 R. 16W

Well No. 2 Deckert "C"

Stanolind & Amerada Company

FIRST REPORT Contractor

NW SW NE

SECTION PLAT

		0	

_____ Ft. from N. Line

990 Ft. from S. Line

_____ Ft. from E. Line

330 Ft. from W. Line

Pawnee County

Location _____

Rig up _____

Drilling and Remarks:

Anhy 1114

8" @ 1118 WOC

RECORD

Cased _____ in., _____ ft.

Sand _____

Gas _____

Oil _____

Total Depth _____

PRODUCTION

1st 24 hrs. Nat. _____

1st 24 hrs. after shot _____

Gas _____ Cu. Ft.

Dry Hole _____

Abandoned _____

Date

FEB 4 1948 19

S. J. LEWIS Scout

Map No. 81 Sec. 24 Twp. 20 R. 16W

Well No. 2 Deckert "C"

Stanolind & Amerada Company

COMPLETE

Contractor

NW SW NE

E 1 2 1/2
SECTION PLAT

 Ft. from N. Line

990 Ft. from S. Line

 Ft. from E. Line

330 Ft. from W. Line

		o	

Pawnee County

Location

Rig up

Drilling and Remarks:

CU 43750
5" "C 3843 1/2
Flow 500

3926

RECORD

Cased in., ft.

Sand

Gas

Oil ✓

Total Depth 3845

PRODUCTION

1st 24 hrs. Nat.

1st 24 hrs. after shot

Gas Cu. Ft.

Dry Hole

Abandoned

Date

MAR 31 1948

19

S. J. LEWIS

Scout