




Butler

Map No. KANSAS Sec. 3 Twp. 25 R. 3E

Well No. 1 - Brainard Farm  
Fairview Oil Company

990 Ft. from N. Line  
\_\_\_\_ Ft. from S. Line  
330 Ft. from E. Line  
\_\_\_\_ Ft. from W. Line

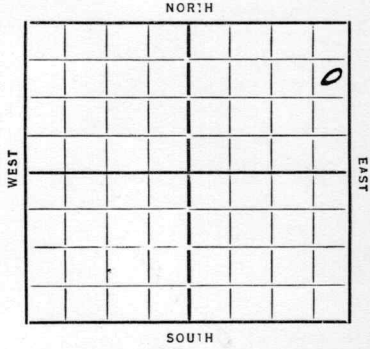

Date	REPORT
7/24	dlg 810
8/8	dlg 1385 10" 1370
8/15	1650 WR 10"
8/22	10" 1662 HFV 1955
	dlg 2050
8/29	8" 2169 440 2395
	dlg 2400
9/6	2733 200' dil 2758 T.D.
10/3	—
10/9	test
10/17	Sand 2733-41 1/2 TD 2758 2000 acid 100 lbs.
	COMPLETED

Map No. 13 Sec. 3 Twp. 25 R. 3E

Well No. 1 Brainard

Fairview Oil Company

Contractor

SECTION PLAT

FIRST REPORTS

990 Ft. from N. Line

..... Ft. from S. Line

330 Ft. from E. Line

..... Ft. from W. Line

			0

Location.....

Rig up.....

Drilling and Remarks:

810

RECORD

Cased.....in., .....ft.

Sand.....

Gas.....

Oil.....

Total Depth.....

PRODUCTION

1st 24 hrs. Nat.....

1st 24 hrs. after shot.....

Gas.....Cu. Ft.

Dry Hole.....

Abandoned.....

Date

7/24/35 192.....

Scout

ORVAL MANNING-SCHRECK

Map No. 13 Sec. 3 Twp. 25 R. 3E

Well No. 1-Brainard

Fairview oil Company

Contractor

COMPLETED

SECTION PLAT

			0

990 Ft. from N. Line

..... Ft. from S. Line

330 Ft. from E. Line

..... Ft. from W. Line

Location.....

Rig up.....

Drilling and Remarks:

2000 acid

100 lbs

RECORD

Cased..... in., ..... ft.

Sand 2733-41 1/2

Gas.....

Oil.....

Total Depth 2758

PRODUCTION

1st 24 hrs. Nat.....

1st 24 hrs. after shot.....

Gas..... Cu. Ft.

Dry Hole.....

Abandoned.....

Date

10-17-35 192.....

Scout

CRYSTAL MANNSCHECK