
FORM 51 10M 8-47 KANSAS Pawnee

Section 24 Township 20 Range 16-W

Well No. #1 Bixby

Company Campbell etal

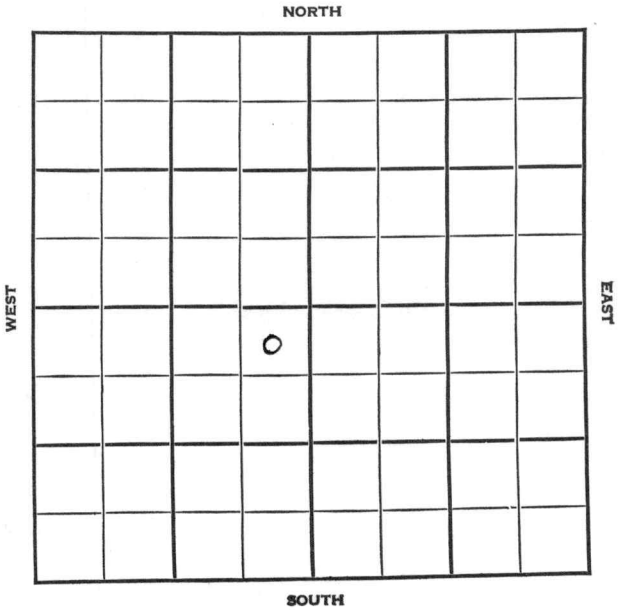

FORM 252-A
5M 4-48 PETROL

KANSAS

Pawnee

Sec. 24 Twp. 20 R. 16W

Well No. #1 Bixby Farm

Campbell et al Company

Pawnee Rock Pool


330' Ft. from N. Line

Ft. from S. Line

330' Ft. from E. Line

Ft. from W. Line

NE SW

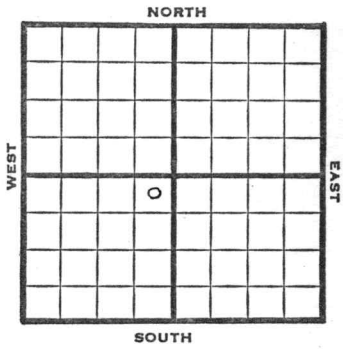

1948	Elev. 2085' REPORT
5/5	Location
5/12	"
5/19	8" @ 1066'
5/26	Drlg. 3100'
6/1	Arbuckle 3785' TD 3814' 5" @ 3812' RUST
6/9	"
6/16	"
6/23	"
6/29	"
7/8	"
7/14	"
7/21	"
7/28	"
8/4	TD 3817' 750 acid.
8/11	Arbuckle 3785' 5" @ 3812' TD 3817' 750 acid Flow 100 oil Pot. Gr. 39°

COMPLETED

Form 26—200 Bks.—1-48—Palace

Pawnee Rock Pool

Kansas

Map No._____ Sec. 24 Twp. 20 R. 16W


Well No. 1 Bixby

Campbell etal. Company

FIRST REPORT Contractor

NE SW

SECTION PLAT

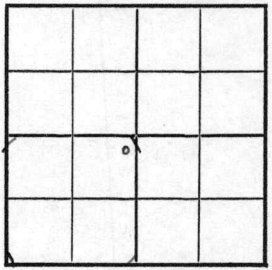

330 Ft. from N. Line

_____ Ft. from S. Line

330 Ft. from E. Line

_____ Ft. from W. Line

Pawnee County

Location x

Rig up

Drilling and Remarks:

RECORD

Cased _____ in., _____ ft.

Sand

Gas

Oil

Total Depth

PRODUCTION

1st 24 hrs. Nat.

1st 24 hrs. after shot

Gas _____ Cu. Ft.

Dry Hole

Abandoned

Date

MAY 5 1948 19____

S. J. LEWIS Scout

Form 27—100 Bks.—4-48—Petrol

Pawnee County Kansas State

Map No. 81 Sec. 24 Twp. 20 R. 16W

Well No. 1 Bixby


Campbell etal. Company

COMPLETE Contractor

NE SW

E. 1,285

SECTION PLAT

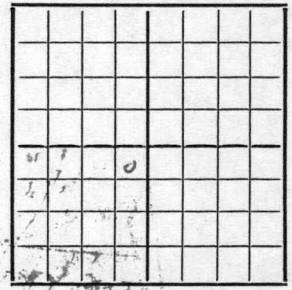

330 Ft. from N. Line

Ft. from S. Line

330 Ft. from E. Line

Ft. from W. Line

Pawnee Rock Pool

Remarks:

Cut 3785

T.D. 3872

T.D. 3817

Isolated

Flow 100 bbl B.S.

39° Gr

Date AUG 11 1948

Scout S. J. LEWIS