

Map No. 135 Sec. 25 Twp. 8 R. 8
 Well No. 135 Oil Farm _____
 _____ Company

NORTH

SOUTH

WEST

EAST

0

COMPLETED

Location _____

Rig Up _____

Drilling Remarks:

Drilling Remarks:

RECORD

PRODUCTION

Cased _____ in. _____ ft.
 Sand _____
 Gas _____
 Oil _____
 Total Depth _____

1st 24 hrs. Nat. _____
 1st 24 hrs. after shot _____
 Gas _____ cu. ft.
 Dry Hole _____
 Abandoned _____

Map No. _____ Sec. 35 Twp. 25 R. 8Well No. 7Great Southern Company

Contractor _____

NORTH

WEST

EAST

SOUTH

Location _____

Rig up ☒

Drilling and Remarks:

RECORD

Cased _____ in., _____ ft.

Sand _____

Gas _____

Oil _____

Total Depth _____

PRODUCTION

1st 24 hrs. Nat. _____

1st 24 hrs. after shot _____

Gas _____ Cu. Ft.

Dry Hole _____

Abandoned _____

Date

5/24 1918 Pyle Scout


Map No. _____ Sec. 35 Twp. 25 R. 8Well No. 7 Hull
Great Southern Company

Contractor _____

NORTH

WEST

EAST

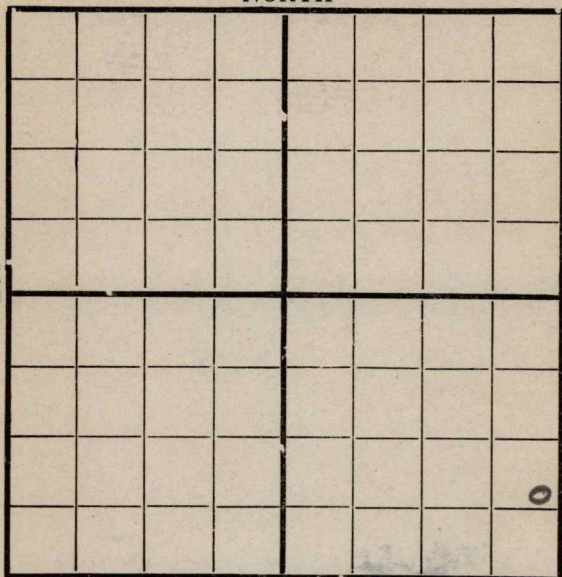

SOUTH

Location _____

Rig up _____

Drilling and Remarks:

Spudding

RECORD

Cased _____ in., _____ ft.

Sand _____

Gas _____

Oil _____

Total Depth _____

PRODUCTION

1st 24 hrs. Nat. _____

1st 24 hrs. after shot _____

Gas _____ Cu. Ft.

Dry Hole _____

Abandoned _____

Date

5/31 1918 Cyle Scout


Map No. _____ Sec. 35 Twp. 25 R. 8Well No. 7 HullGreat Southern Company

Contractor _____

NORTH

WEST

EAST

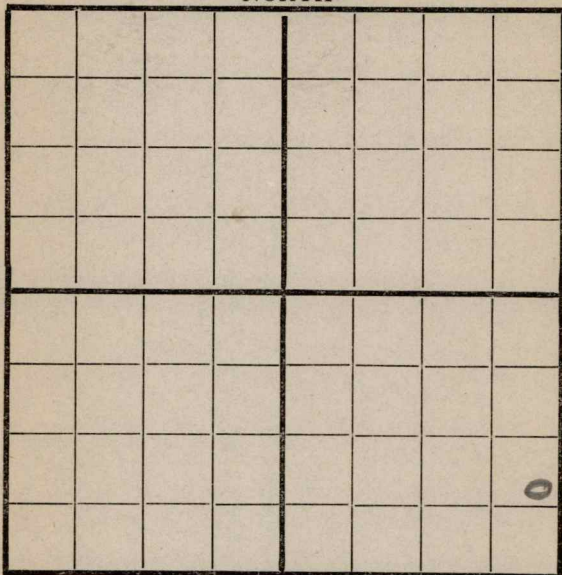

SOUTH

Location _____

Rig up _____

Drilling and Remarks:

400'

RECORD

Cased _____ in., _____ ft.

Sand _____

Gas _____

Oil _____

Total Depth _____

PRODUCTION

1st 24 hrs. Nat. _____

1st 24 hrs. after shot _____

Gas _____ Cu. Ft.

Dry Hole _____

Abandoned _____

Date

6/7 1918Gyle Scout

Map No. _____ Sec. 33 Twp. 25 R. 8

Well No. 7 Hull

Great Southern Company

Contractor

NORTH

WEST

EAST

SOUTH

Location _____

Rig up.....

Drilling and Remarks:

925

RECORD

Cased _____ in., _____ ft.

Sand_____

Gas -----

O:1_____

Total Depth_____

PRODUCTION

1st 24 hrs. Nat. _____

1st 24 hrs. after shot-----

Gas.....Cu. Ft.

Dry Hole

Abandoned.....

Date _____

Date 6/4 1918 Pyle Scout

Map No. _____ Sec. 35 Twp. 25 R. 8Well No. 7 HullGreat Southern Company_____
Contractor

NORTH

WEST

EAST

SOUTH

Location _____

Rig up _____

Drilling and Remarks:

1300'

RECORD

Cased _____ in., _____ ft.

Sand _____

Gas _____

Oil _____

Total Depth _____

PRODUCTION

1st 24 hrs. Nat. _____

1st 24 hrs. after shot _____

Gas _____ Cu. Ft.

Dry Hole _____

Abandoned _____

Date

9/21 1918Gyle Scout

Map No. K 15 Sec. 35 Twp. 25 R. 8Well No. 75 ShullTidal Oil Company

Contractor

NORTH

WEST

EAST

SOUTH

CHANGE LESSEE NAME

Location _____

Rig up _____

Drilling and Remarks:

D. D. @1300'

RECORD

Cased _____ in., _____ ft.

Sand _____

Gas _____

Oil _____

Total Depth _____

PRODUCTION

1st 24 hrs. Nat. _____

1st 24 hrs. after shot _____

Gas _____ Cu. Ft.


Dry Hole _____

Abandoned _____

Date

6/26 1918 P. y. h Scout

Map No. _____ Sec. 35 Twp. 25 R. 8
 Well No. 7 Hull Farm _____
Tidal Oil Company _____
 Date Started _____ Ft. from N. _____ S. _____ E. _____ W. _____ line
 NORTH

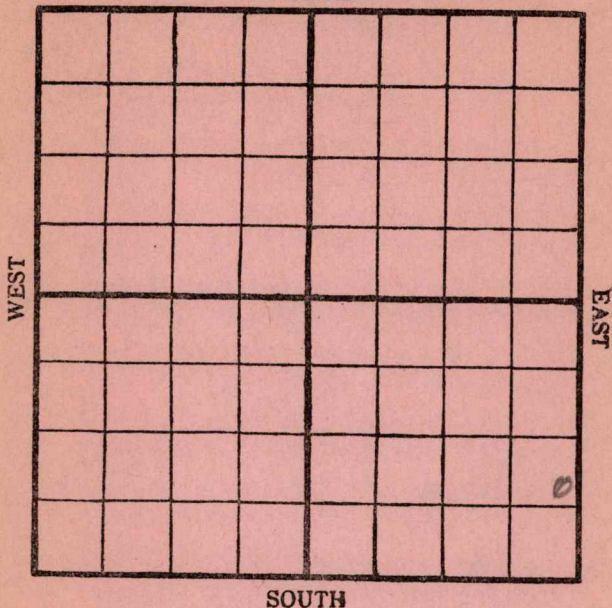

Cased _____ In. _____ Ft. _____
 Sand _____
 Pay { Gas _____
 { Oil _____
 Total Depth _____

Production Remarks

Condition of Well on this date _____


Top Sand 2303'
33' in looking
good

7/4 *Oy a* Scout

Map No. K13 Sec. 35 Twp. 25 R. 8Well No. 7 Hull FarmTidal Company

NORTH

WEST

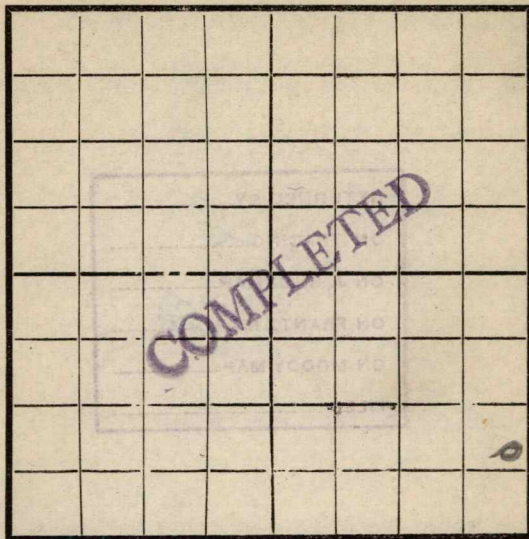

EAST

SOUTH

Location -----

Rig Up -----

Drilling and remarks -----

RECORD

Cased ----- in. ----- Ft.

Sand 2332-2394

Gas -----

Oil -----

Total Depth -----

PRODUCTION

1st 24 hrs. Nat. 150 bbl

1st 24 hrs. after shot -----

Gas ----- Cu. Ft.

Dry Hole -----

Abandoned -----

Date

7/9, 1918 July Scout