


Butler KANSAS

Section 2 Township 25 Range 3E

Well No. #2 Lang

Company Crest Petr.

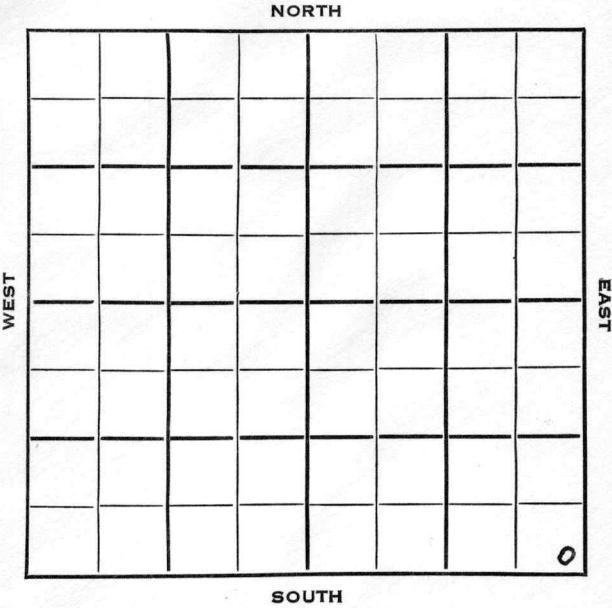

Butler

KANSAS

SEC.

2

TWP.

25

R.

3E

WELL NO.

#2 Lang

FARM

COMPANY

Crest Pet.

CONTRACTOR

Potwin Pool

Ft. from N. Line

230


Ft. from S. Line

230

Ft. from E. Line

Ft. from W. Line

SE SE SE

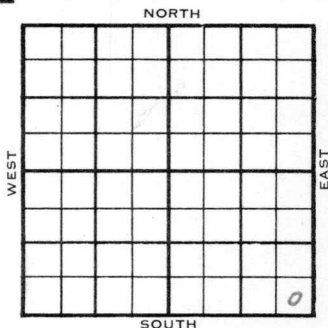

1953

ELEVATION

1302'

REPORT

9/2

Location

11/4

Spud 9-20-53

Oil Well

TD 2700'

8" @ 75'

Miss 2688'

TD 2690

5" @ 2688

DD 2700, 4000A,

S/2 boph

Comp. 25 bopd

COMPLETED

County **Butler** State **Kansas**

Sec. **2** (Blk.) **25** (Sur.) **3E** Map No.

Operator Crest Pet.

Well No. 2 Farm Leng

Elev.	Location	SE SE SE

0

230 Ft. From S Line SE

230 Ft. From E Line Quarter

1st. Report SEP 2 1953

Completion

Remarks

Spudding Date _____

Drlg. Data Potwin Pool

Location

J. G. McGEHEE