
Form 51—5M—3-35—Mid-West

Map No. KANSAS Sec. 7 Twp. 25 R. 3E Butler

Well No. 1 E. J. McCamper Farm

Vickers Pet Company

NORTH

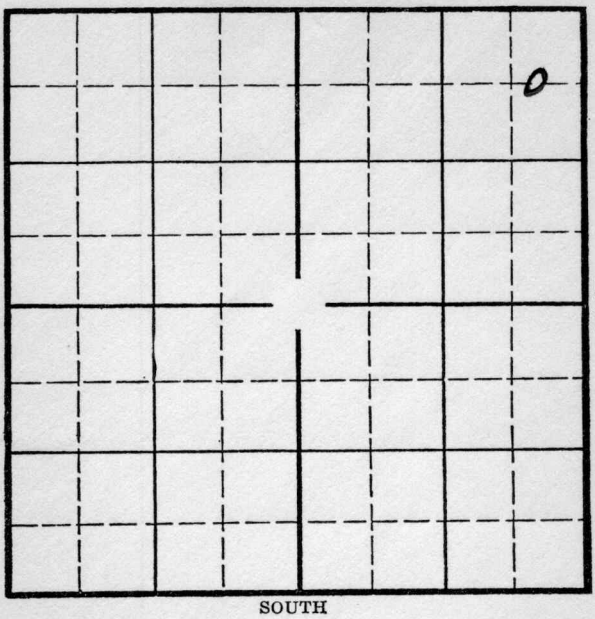

Location

Drilling Remarks

Rig Up

Drilling Remarks

RECORD

Cased ____ in. ____ ft.

Sand

Gas

Oil

Total Depth

PRODUCTION

1st 24 hrs. Nat.

1st 24 hrs. after shot

Gas ____ cu. ft.

Dry Hole

Abandoned

Form 252-A
5M 7-34 MPC

Butler

KANSAS

Map No. _____ Sec. 2 Twp. 25 R. 3E

Well No. 5-17 McCranie Farm


Vickers Pit Company

660 Ft. from N. Line

_____ Ft. from S. Line

440 Ft. from E. Line

_____ Ft. from W. Line

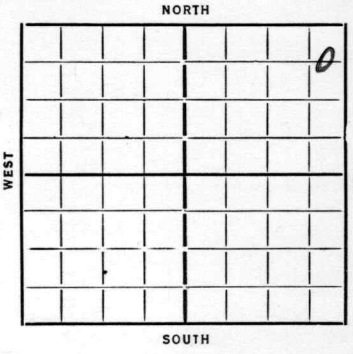

Elev. 1336

Date 1935	REPORT
6/5	Location
6/13	—
6/20	Rig
6/28	Spud
7/3	Dly 1050 15"46
7/11	" 1310 12" 1130
7/18	" 1614
8/8	TL 2704 Oil 2708-14
	6" 2704 Est 25 Bbls
8/15	1000 acid
8/21	Lime 2704
	TD 2714
	1000 acid
	170 Oil
	5 Wtr

COMPLETED

Form 26—1M Bks. 9-28

Butler KANSAS

Map No. 13 Sec. 2 Twp. 25 R. 3E

Well No. 10 - McCramer

Vickers Pet. Company

Contractor

FIRST REPORTS


660 Ft. from N. Line

Ft. from S. Line

440 Ft. from E. Line

Ft. from W. Line

SECTION PLAT

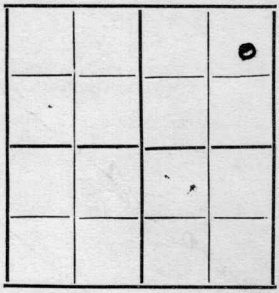

Location ✓

Rig up

Drilling and Remarks:

RECORD

Cased in., ft.

Sand

Gas

Oil

Total Depth

PRODUCTION

1st 24 hrs. Nat.

1st 24 hrs. after shot

Gas Cu. Ft.

Dry Hole

Abandoned

Date

6-5-35 192

ORVAL MANNSCHRECK Scout

Form 26—1M Blks 9-28

Butler KANSAS

Map No. 13 Sec. 2 Twp. 25 R. 3E

Well No. 10-M. C. Cramer

Vickers Petroleum Company

Contractor

COMPLETED


660 Ft. from N. Line

Ft. from S. Line

440 Ft. from E. Line

Ft. from W. Line

SECTION PLAT

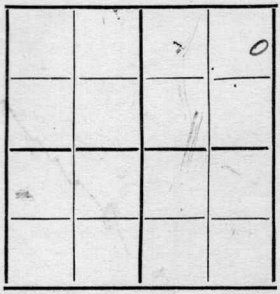

Location

Rig up

Drilling and Remarks:

1000 acid

170 oil
5 water

RECORD

Cased 1 in., ft.

Sand Lime 2704

Gas

Oil

Total Depth 2714

PRODUCTION

1st 24 hrs. Nat.

1st 24 hrs. after shot

Gas Cu. Ft.

Dry Hole

Abandoned

Date

8-21-35 192

ORVAL MANNSCHRECK Scout